


Section 33 Township 8 Range 19W

Well No. 2 Rostocil

Company Skelly

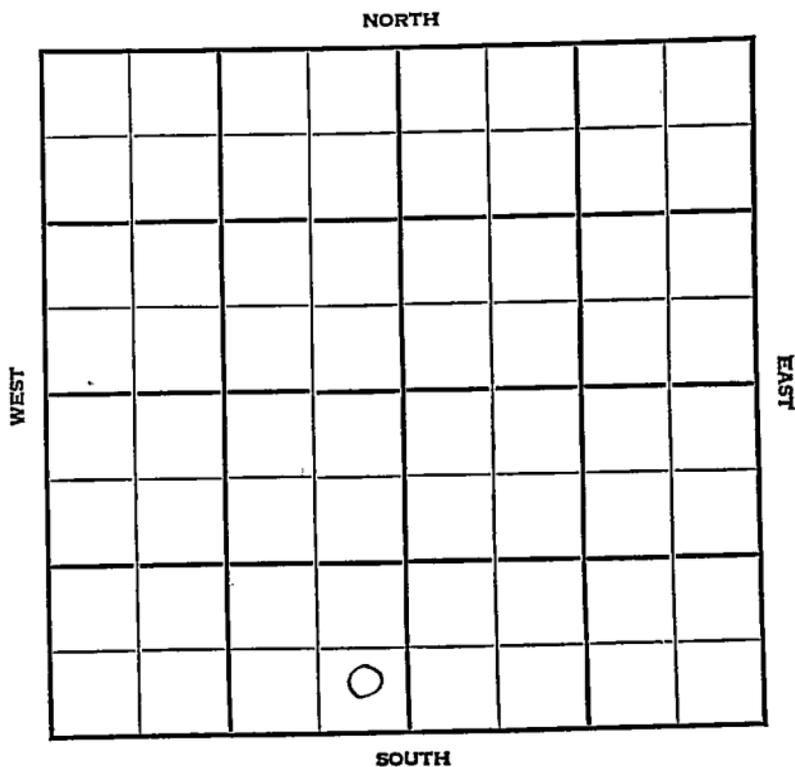



Sec. 33 Twp. 8 R. 19W

Well No. #2 Rostocil Farm

Skelly

Company

Barry Pool


_____ Ft. from N. Line

330' Ft. from S. Line

330' Ft. from E. Line

_____ Ft. from W. Line

SE SW

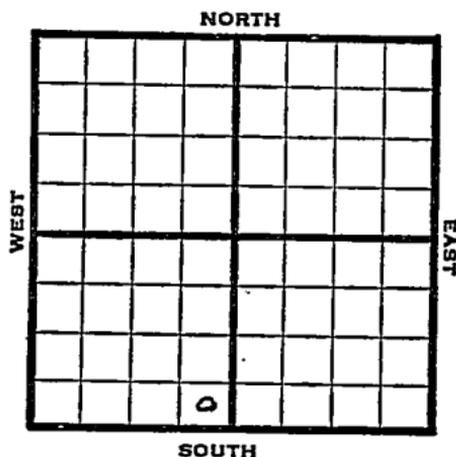

1948

Eli 2016'

R E P O R T

7/28 Drlg. 1165'

8/4 8" @ 1440'
Drlg. 2805'

8/11 Lansing 3209'
Arbuckle 3514'
TD 3531'
SD

8/18 Lansing 3209'
Cong. 3457'
Arb. 3514'
TD 3531'
~~Hand.~~

ABANDONED

Rooks County Kansas State

Map No. _____ Sec. 33 Twp. 8 R. 19W


Well No. 2 Rostocil

Skelly Company

FIRST REPORT Contractor

SE SW

SECTION PLAT

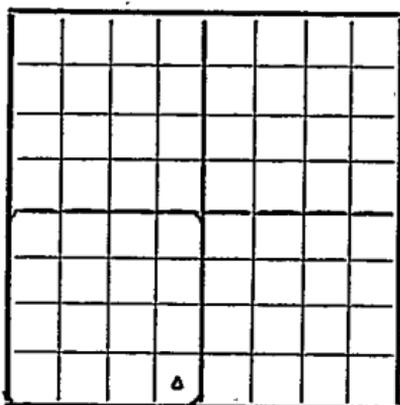

_____ Ft. from N. Line

330 Ft. from S. Line

330 Ft. from E. Line

_____ Ft. from W. Line

Barry Pool

Remarks:

Drig. 1165

Date JUL 28 1948

Scout S. J. LEWIS

