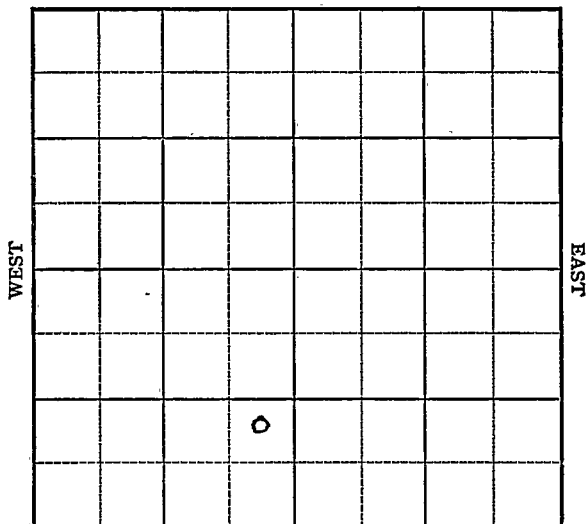


KANSAS

Rooks

O. W. P. B.

Section 33 Township 8 Range 19WWell No. 6^{Frank} RostocilCompany Skelly OilBarry Pool
NORTH

SOUTH

KANSASO. W. P. Brooks

Sec. 33 Twp. 8 R. 19W ✓

Well No. #6 Rostocil Farm

Skelly Oil Company

Barry Pool

Ft. from N. Line

990'


Ft. from S. Line

330'

Ft. from E. Line

Ft. from W. Line

NE SE SW

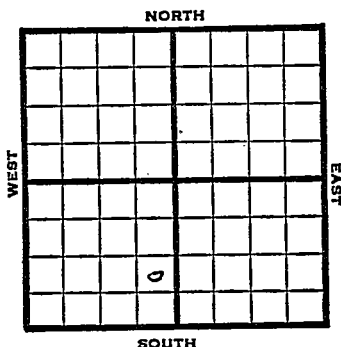

1949 ^{2011'}
Elev ^{2009'} REPORT

3/16 Location

3/23 13" @ 197'
Drlg. 1776'

3/30 Drlg 3029'

4/6 Lansing 3204'
Arbuckle 3446-50'
TD 3450'

Run 5"
4/12 5" @ 3446'

4/20 TD 3450'
Arb. 3446'
5" @ 3446'
Pump 128 Oil $\neq$ 4% W Pot
Comp

COMPLETED

~~###~~

O. W. P. B.

1956

3-7 OTD 3450
5" @ 3445, PB 3320, 54/ 3296-3307, 500 A
B/ 20 gwph 8 hrs., PB 3292, 48/ 3282-90
500 A
B/ 15 gwph, 11 hrs., PB 3254, 24/3242-46
500 A,
S/11 bw 10 hrs., PB 3230, 36/3220-26,
500 A,
S/ 6 go 3 bwph, 8 hrs., PB 3216,
42/3205-12, 500 A, S/ 2 bwph, 10 hrs.

OVER

PB 3200, 30/3186-91, 12/ 3194-96
500 A
S/ 10 go 5 bwph, 5 hrs., PB 3193
1500 A
S/ 6 bo 95 bw 11 hrs.
Comp. 10 bopd, 109 bw
H. 3164
Tr. 3186
L. 3204
BKC 3419
A. 3444

FIRST REPORT

[Signature]

COMPLETED

Kansas.

Map No. _____ Sec. 33 Twp. 8 R. 19WWell No. 6 Rostocil

Skelly

Company

FIRST REPORT

Contractor

NE SE SW

SECTION PLAT

_____ Ft. from N. Line

990 Ft. from S. Line330 Ft. from E. Line

_____ Ft. from W. Line

Rooks County

Location X

Rig up _____

Drilling and Remarks:

RECORD

Cased _____ in., _____ ft.

Sand _____

Gas _____

Oil _____

Total Depth _____

PRODUCTION

1st 24 hrs. Nat. _____

1st 24 hrs. after shot _____

Gas _____ Cu. Ft.

Dry Hole _____

Abandoned _____

Date

MAR 16 1949

19

S. J. LEWIS

Scout

Kansas

Map No. K65 Sec. 33 Twp. 8 R. 19WWell No. 6 Rostocil

Skelly

Company

COMPLETE

Contractor

NE SE SW

E1.2011
SECTION PLAT

Ft. from N. Line

990 Ft. from S. Line

330 Ft. from E. Line

Ft. from W. Line

Rooks County

Location

Rig up

Drilling and Remarks:

Cased 3446

5" C3446

Pump 1250 ft

4 1/2 W P 2

32 2/3

RECORD

Cased _____ in., _____ ft.

Sand _____

Gas _____

Oil _____

Total Depth 3450

PRODUCTION

1st 24 hrs. Nat. _____

1st 24 hrs. after shot _____

Gas _____ Cu. Ft.

Dry Hole _____

Abandoned _____

Date

APR 20 1949

19

S. J. LEWIS

Scout

O. W. P. B

O. W. P. B

FORM 513 REV. SUNRAY

County Rooks Elev. 2011
 Sec. 33 Twp. 8 Rge. 19W
 Company Skelly Oil
 Farm Name Frank Rostocii No. 6

TOPS	DEPTH	LOG	DATUM
Anh.			
Tp.			
H.	3164		
Tr.	3186		
Dg.			
BL.			
L.	3204		
K.C.			
B.K.C.	3419		
Ce.			
C.			
M.			
M.			
K.			
Mz.			
Mq.			
V.			
S.			
S.			
A.	3444		
R.			
PE.			
G.			
T.D.			

Loc. in Sec.

NE SE SW

Geol.

Contr.

Pool

Webster

FIRST REPORT
COMPLETE
0 MAR 7 '58

Date Comm.

OTD 3450 5" @ 3445 PB 3320

54/ 3296-3307 500 A B/ 20 gaph 8 hr

PB 3292 48/ 3282-90 500 A B/ 15 gwph

11 hr. PB 3254 24/ 3242-46 500 A

S/ 11 hr 10 hr. PB 3230 36/ 3220-26

500 A S/ 6 go 3 bwph 8 hr. PB 3216

42/ 3205-12 500 A S/ 2 bwph 10 hr.

PB 3200 30/ 3186-91 12/ 3194-96

500 A S/ 10 go 5 bwph 5 hr. PB 3193

1500 A S/ 6 bo 95 bw 11 hr.

Comp. 10 bopd 109 bw

R. G.
MAR 1 3 1956