


Section 33 Township 8 Range 22W

Well No. #1 DeSaire

Company Harry Gore

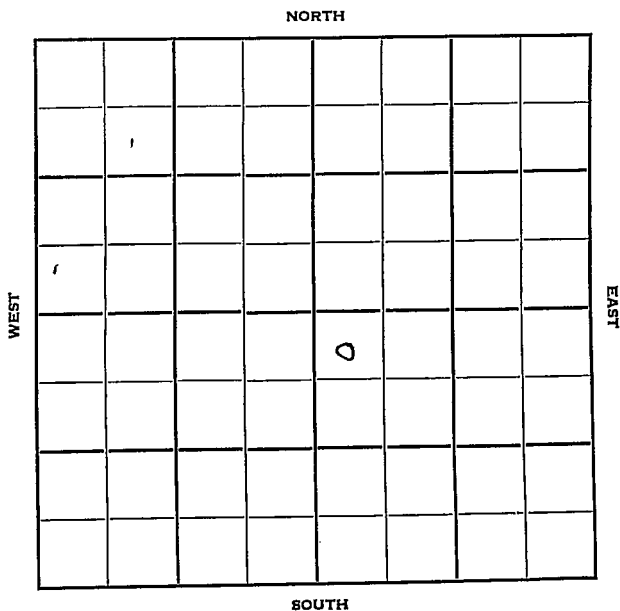

Graham

8

KANSAS  
R.

22W

Sec. 33 Twp.

Well No. #1 DeSaire Farm

Harry Gore Company

Veeder Contractor

Wildcat


330 Ft. from N. Line

Ft. from S. Line

Ft. from E. Line

330 Ft. from W. Line

SE  $\frac{1}{4}$  NW NW SE  
Skelly & Deep Rock DHM

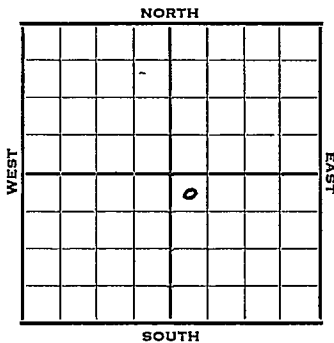

1952 Elev. 2267' REPORT

10/22 Spud 10-16-52  
8" @ 220  
Anhy 1820'  
Drlg. 2825'

10/29 Spud 10-16-52  
D & A TD 3941' 8" @ 200 Anhy 1820  
Top 3262' Heeb 3487' Tor. 3513'  
Lans. 3526' B KC 3749' Cong 3885'  
Re-Arb. 3891' Arb. 3898'  
TD 3941' D & A

**ABANDONED**



