
FORM 51 25M 3-49 PETROL Thomas KANSAS

Section 33 Township 8 Range 32W

Well No. #1 Misner

Company Ashland Oil

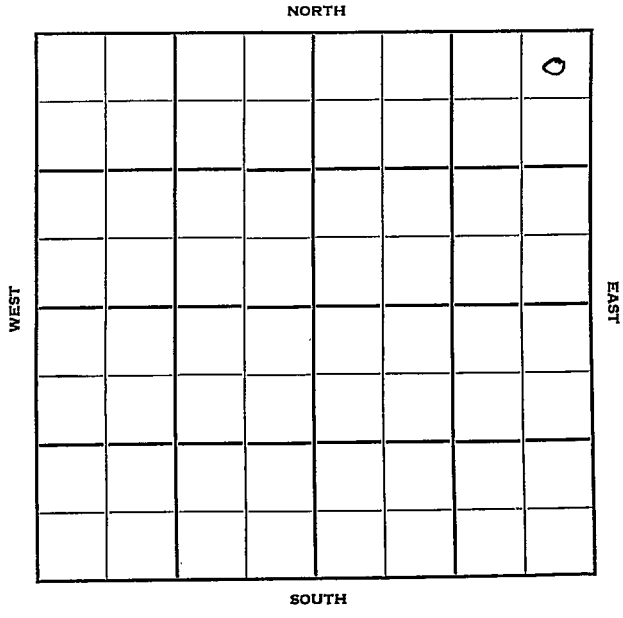

FORM 252-B
10M 11-50 PETROL

KANSAS ✓

Thomas

Sec. 33 Twp. 8 R. 32W

Well No. #1 Misner Farm

Ashland Oil Company

Contractor

Wildcat

330 Ft. from N. Line


Ft. from S. Line

330 Ft. from E. Line

Ft. from W. Line

NE NE NE

Superior DHM

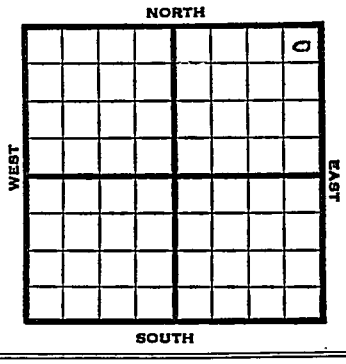

1952 Elev. 3082 REPORT

10/8 Location

10/15 "

10/22 "

10/29 "

11/5 "

11/12 "

11/20 "

11/27 "

12/4 Dakota 1780' Heeb 4043' Tor 4055'
DST 4052-72, 2 hrs, 60' M, 210' SW
850# Lans. 4088'
Drlg. 4095'

12/11 DST 4611 - 21 ½ hr. 15' m 0# Miss
4664 Ø 4760

12/17 Spud 11-21-52
D&A
TD 5033'
8" @ 230
Dakota 1780, Heeb 4043, Tor. 4055
DST 4052-72, opn 2 hrs., rec. 60' mud, 210' sw 850#, Lans 4088
DST 4611-21, opn ½ hr., rec. 15' mud 0#

OVER

(Information Brought Forward)

1952
12/17 Miss 4664, Viola 4974, Arb. 5005'
TD 5033
D&A

ABANDONED

FORM 275 FOR SALE BY KANSAS BLUE PRINT CO.


County Thomas State Kansas

Sec. 33 (Blk. Twp.) 8 (Sur. Rge.) 32W Map No.

Operator Ashland Oil

Well No. 1 Farm Misner

Elev. Location NE NE NE

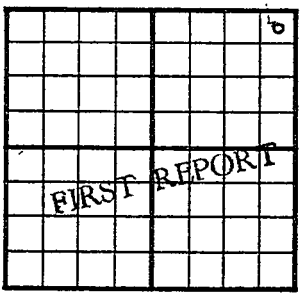

330 Ft. From N Line NE

330 Ft. From E Line Quarter

1st. Report OCT 8 1952

Completion

Remarks Superior - IHM

Spudding Date

Drlg. Data Wildcat

Location

J. G. McGEHEE

FORM 275 FOR SALE BY KANSAS BLUE PRINT CO.


County Thomas State Kansas

Sec. 33 (Blk. Twp.) 8 (Sur. Rge.) 32W Map No.

Operator Ashland Oil

Well No. 1 Farm Misner

Elev. 3082 Location NE NE NE

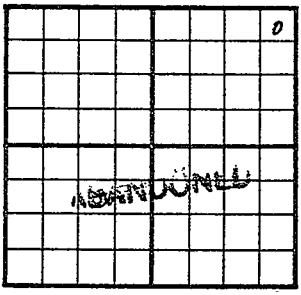

330 Ft. From N Line NE

330 Ft. From E Line Quarter

1st. Report

Completion DEC 17 1952

Remarks Wildcat

Spudding Date 11-21-52

Drlg. Data D & A TD 5033

8" @ 230 Dakota 1780 Heeb. 4043

Tor. 4055 DST 4052-72 open 2 hr.

Rec. 60' mud 210' sw 850# Lans. 4088

DST 4611-21 open ½ hr. Rec. 15' mud 0#

Miss. 4664 Viola 4974 Arb. 5005

TD 5033

D & A

J. G. McGEHEE