

Sec. 34 Twp. 8 R. 16W

Well No. #3 Hobson Farm _____

Cities Service Company


Laton Pool
990 Ft. from N. Line

_____ Ft. from S. Line

_____ Ft. from E. Line

660 Ft. from W. Line

C S L- NW NW

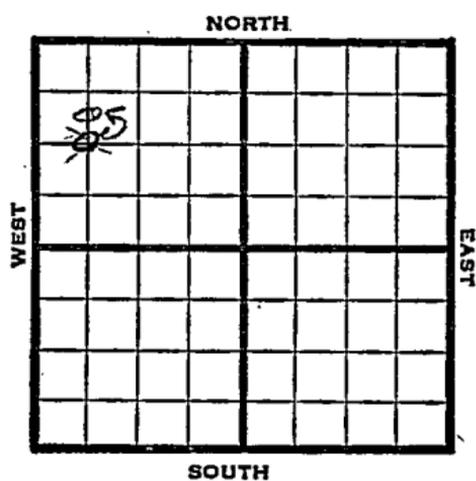

1947 Elev. 1948 REPORT

4/30	0	8" @ 240 Lans. 3051 SO 3056-58 3093-3101 TD 3287 4" @ 3287 Rust
5/7	"	"
5/13		TD 3287
5/20		Packee 3195 2000 Acid and 2000 acid 3056-3145-, 2000 acid 3156-72
5/27	"	"
6/3	"	"
6/10	"	"
6/21	"	"
6/24	"	"
7/1	"	"
7/8	"	"
7-16	"	" OVER

1947

7/22 2000 Acid
3156-72'

7/29 "

8/6 "

8/13 "

8/20 "

8/27 "

9/3 "

9/10 Lans. 3050'
4" @ 3287'
Perf.
6000 Acid
Pump 25 Pot.
Gr. 27°
Total Depth 3287'
COMPLETED

Map No. 64 Sec. 34 Twp. 8 R. 16W

Well No. 3 Hobson

Cities Service Company

FIRST REPORT Contractor

C S L NW NW

SECTION PLAT

990 Ft. from N. Line

_____ Ft. from S. Line

_____ Ft. from E. Line

660 Ft. from W. Line

Rooks County

RECORD

Location _____

Cased 7 1/2 in., _____ ft.

Rig up _____

Sand _____

Drilling and Remarks:

Gas _____

8" @ 240

Oil _____

Lans. 3051

Total Depth _____

SO 3056-58

3093-3101

TD 3287

4" @ 3287 RUST

PRODUCTION

1st 24 hrs. Nat. _____

1st 24 hrs. after shot _____

Gas _____ Cu. Ft.

Dry Hole _____

Abandoned _____

Date

APR 3 0 1947

19

S. J. LEWIS

Scout

Map No. 104 Sec. 34 Twp. 8 R. 16W

Well No. 3 Hobson

Cities Service Company

COMPLETE

Contractor

C S L NW NW


E 11948
SECTION PLAT

990 Ft. from N. Line

 Ft. from S. Line

 Ft. from E. Line

660 Ft. from W. Line

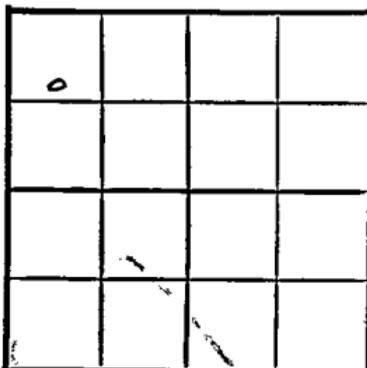

Rooks County

RECORD

Location _____

Rig up _____

Drilling and Remarks:

Leas 8050

4" @ 287

*Perf
6000 acid*

Pump 2500 ft.

270 ft

Cased _____ in., _____ ft.

Sand _____

Gas _____

Oil _____

Total Depth 3387

PRODUCTION

1st 24 hrs. Nat. _____

1st 24 hrs. after shot _____

Gas _____ Cu. Ft.

Dry Hole _____

Abandoned _____

Date

SEP 10 1947 19

S. J. LEWIS

Scout