

KANSAS


Rooks

FORM 51 5M 1-42 PETROL

Section 34 Township 8 Range 16 ^W

Well No. #1 Swisher

Company Bay Petroleum

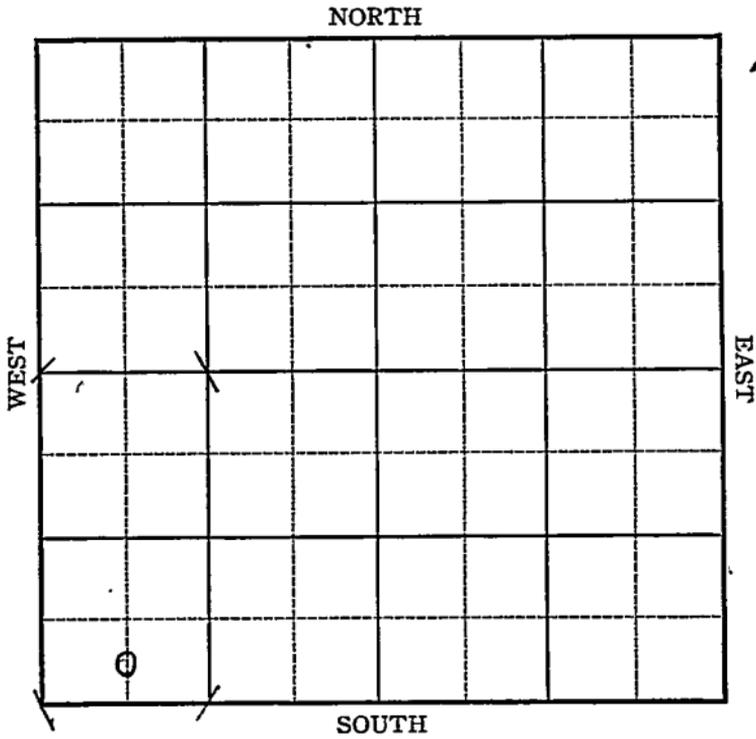

Sec. 34 Twp. 8 R. 16-W

Well No. #1 Swisher Farm

Bay Petroleum Company


_____ Ft. from N. Line

330 Ft. from S. Line

_____ Ft. from E. Line

660 Ft. from W. Line

Elms. 1951

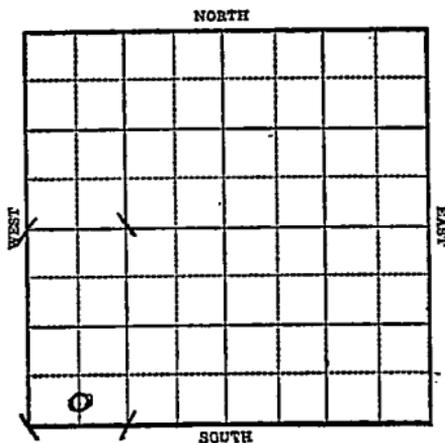

1943

R E P O R T

5/5	Location	Sinclair-Prairie farmout
5/12	Rotary	
5/22	Anhy 1230 Drlg. 2400'	
5/26	Lans 3077 T.D. 3107	
6/2	SD for csg 7" @ 3099 Drlg. 3111-60' oil	
6/9	Lans 3071 T.D. 3141-3000 acid 1000' oil	
6/16	Swab 35 oil per hr.	
6/23	Lans 3071 7" @ 3099' T.D. 3141' 1000 gal. acid Pump 278 Pot. Gravity 38	

COMPLETED

Map No. KANSAS Sec. 34 Twp. 8 R. 16W

Well No. 1 Swisher

Bay Petroleum Company

FIRST REPORT

Contractor

C SL SW SW

SECTION PLAT

Ft. from N. Line

330 Ft. from S. Line

Ft. from E. Line

660 Ft. from W. Line

LATON POOL

Location XXX

Rig up _____

Drilling and Remarks:

Sinclair-Prairie
farmout

RECORD

Cased _____ in., _____ ft.

Sand _____

Gas _____

Oil _____

Total Depth _____

PRODUCTION

1st 24 hrs. Nat. _____

1st 24 hrs. after shot _____

Gas _____ Cu. Ft.

Dry Hole _____

Abandoned _____

Date

MAY 5 1943 19

S. J. LEWIS Scout

Rooks

KANSAS

Map No. 64 Sec. 34 Twp. 8 R. 16W

Well No. 1 Swisher

Bay Petroleum Company

COMPLETED Contractor

C SL SW SW

SECTION PLAT

_____ Ft. from N. Line

330 Ft. from S. Line

_____ Ft. from E. Line

660 Ft. from W. Line

LATON POOL

Location _____

Rig up _____

Drilling and Remarks:

Line 3071

7" C8099

1000 acid

Pump 278 P & V.

350 gal

RECORD

Cased _____ in., _____ ft.

Sand _____

Gas _____

Oil _____

Total Depth 3141

PRODUCTION

1st 24 hrs. Nat. _____

1st 24 hrs. after shot _____

Gas _____ Cu. Ft.

Dry Hole _____

Abandoned _____

Date

JUN 23 1943 19

S. J. LEWIS Scout