

**KANSAS**


FORM 51 5M PETROL

Rooks

Section 34 Township 8 Range 16W

Well No. #2 Hodson

Company Cities Service Oil

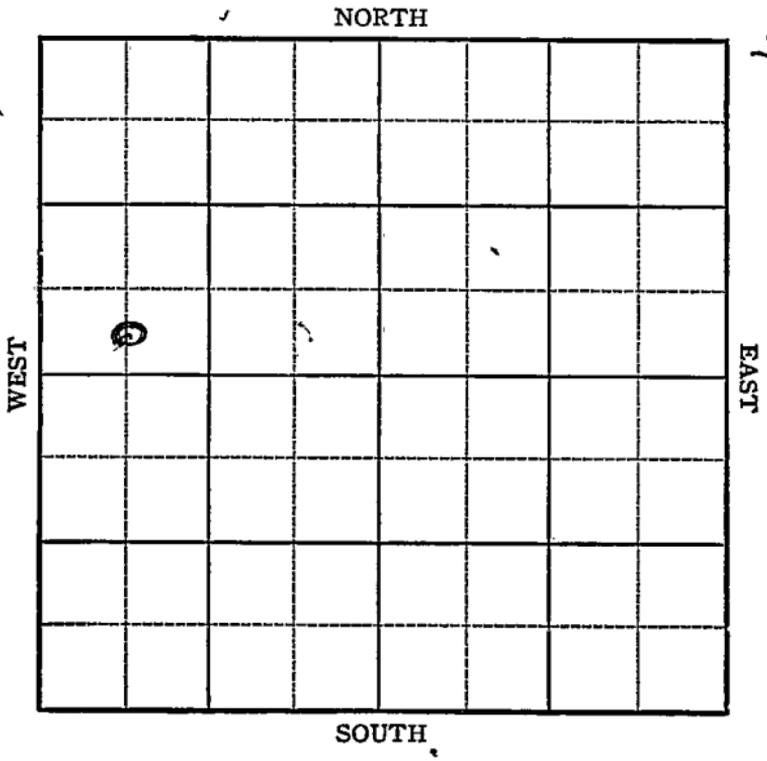

**Rooks**

Sec. 34 Twp. 8 R. 16W


Well No. #2 Hodson Farm

Cities Service Oil Company

**Laton**

\_\_\_\_\_ Ft. from N. Line  
330 Ft. from S. Line  
\_\_\_\_\_ Ft. from E. Line  
660 Ft. from W. Line

*elev. 1917*

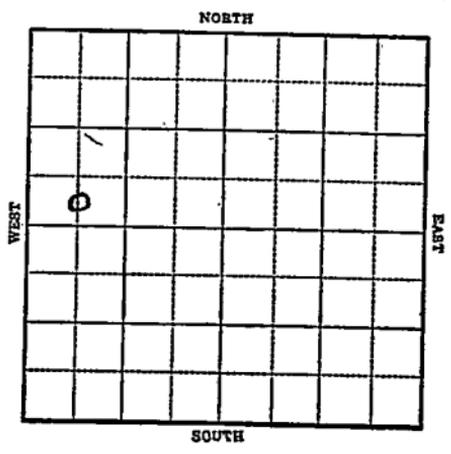

1944	R E P O R T
3/22	Location
3/29	"
4/5	"
4/12	Rotary
4/19	"
4/26	"
5/3	"
5/10	8" @ 241 WOC
5/17	Drilling 2275
5/24	Lans 3028 Sat 3082-85 TD 4" @ 3082 RUST
5/31	"
6/7	Lans 3025 (corrected) 4" @ 3080 TD 3099-1200' oil 5000 acid.

**OVER**

1944

6/21    Lans        3025  
         4" @        3080  
         T:D?       3099  
         5000 Acid  
         Pump 216 Pot.  
         38. Gr.

**COMPLETED**

**KANSAS**

**Rooks**

Map No. 64 Sec. 34 Twp. 8 R. 16W

Well No. 2 Hodson

Cities Service Oil Company

**FIRST REPORT**

Contractor

**C S L SW NW**

**SECTION PLAT**

\_\_\_\_\_ Ft. from N. Line

330 Ft. from S. Line

\_\_\_\_\_ Ft. from E. Line

660 Ft. from W. Line


**Laton Pool**

Location X

Rig up \_\_\_\_\_

Drilling and Remarks:

**RECORD**

Cased \_\_\_\_\_ in., \_\_\_\_\_ ft.

Sand \_\_\_\_\_

Gas \_\_\_\_\_

Oil \_\_\_\_\_

Total Depth \_\_\_\_\_

**PRODUCTION**

1st 24 hrs. Nat. \_\_\_\_\_

1st 24 hrs. after shot \_\_\_\_\_

Gas \_\_\_\_\_ Cu. Ft.

Dry Hole \_\_\_\_\_

Abandoned \_\_\_\_\_

Date

MAR 22 1944 19

S. J. LEWIS

Scout

Pool Name Laton

Map No. 64 Sec. 34 Twp. 8 R. 16W

Well No. 2 Hodson

Cities Service Oil Company

**COMPLETED** Contractor

**C S L SW NW**

**SECTION PLAT**

0			
1			

\_\_\_\_\_ Ft. from N. Line

330 Ft. from S. Line

\_\_\_\_\_ Ft. from E. Line

660 Ft. from W. Line

**Rooks County**

**RECORD**

Location \_\_\_\_\_

Cased \_\_\_\_\_ in, \_\_\_\_\_ ft.

Rig up \_\_\_\_\_

Sand \_\_\_\_\_

Drilling and Remarks:

Gas \_\_\_\_\_

Oil \_\_\_\_\_

*Leave 3025*

Total Depth 3089

*4" @ 3080*

*500 acid*

**PRODUCTION**

1st 24 hrs. Nat. \_\_\_\_\_

1st 24 hrs. after shot \_\_\_\_\_

Gas \_\_\_\_\_ Cu. Ft.

Dry Hole \_\_\_\_\_

Abandoned \_\_\_\_\_

*Pump 216 P.D.*

*38° G.*

Date

JUN 21 1944 19

S. J. LEWIS Scout