

# KANSAS


Rooks

FORM 51 5M 1-42 PETROL

Section 34 Township 8 Range 16 W

Well No. #2 Swisher

Company Bay Pet.

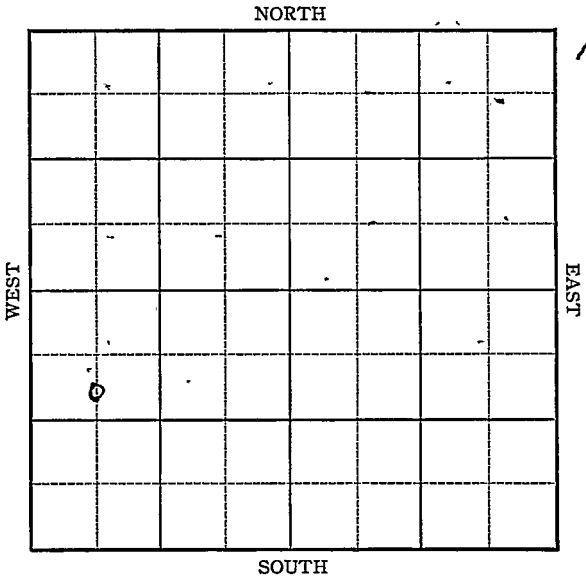

**KANSAS**

Rooks

Sec. 34 Twp. 8 R. 16-W

Well No. #2 Swisher Farm

Bay Petroleum Company


Laton

990 Ft. from N. Line

\_\_\_\_\_ Ft. from S. Line

\_\_\_\_\_ Ft. from E. Line

660 Ft. from W. Line

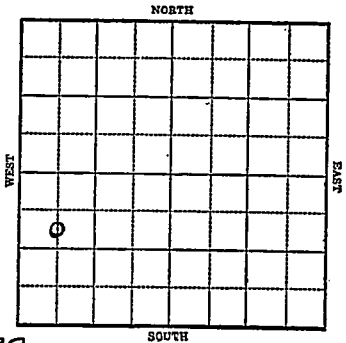

*Elev. 1938*

1943

**R E P O R T**

6/23 Location.

6/30 10" @ 90'  
Anñy 1218  
Drlg. 2865'

7/7 Lans 3053  
SO 3087-91 T.D.  
7" @ 3087 Rust

7/15 T.D. 3128-500' oil 5000 acid.

7/21 Estimate 300 bbls oil

7/28 Lans 3087  
7" @ 3087'  
T.D. 3128'  
5000 gal. acid  
Pump 300 Pot.  
Gravity 38

**COMPLETED**

Rooks

Map No. 67 Sec. 34 Twp. 8 R. 16W

Well No. 2 Swisher

Bay Petroleum

Company

FIRST REPORT

Contractor

C SL NW SW

SECTION PLAT

990 Ft. from N. Line

\_\_\_\_\_ Ft. from S. Line

\_\_\_\_\_ Ft. from E. Line

660 Ft. from W. Line


LATON POOL

RECORD

Location XXX

Cased \_\_\_\_\_ in., \_\_\_\_\_ ft.

Rig up \_\_\_\_\_

Sand \_\_\_\_\_

Drilling and Remarks:

Gas \_\_\_\_\_

Oil \_\_\_\_\_

Total Depth \_\_\_\_\_

PRODUCTION

1st 24 hrs. Nat. \_\_\_\_\_

1st 24 hrs. after shot \_\_\_\_\_

Gas \_\_\_\_\_ Cu. Ft.

Dry Hole \_\_\_\_\_

Abandoned \_\_\_\_\_

Date

JUN 23 1943 19

S. J. LEWIS Scout

Rooks

KANSAS

Map No. 4 Sec. 34 Twp. 8 R. 16W

Well No. 2 Swisher

Bay Petroleum Company

**COMPLETED** Contractor

C SL NW SW

SECTION PLAT

990 Ft. from N. Line

o			
	-		

\_\_\_\_\_ Ft. from S. Line

\_\_\_\_\_ Ft. from E. Line

660 Ft. from W. Line

LATON POOL

RECORD

Location \_\_\_\_\_

Cased \_\_\_\_\_ in., \_\_\_\_\_ ft.

Rig up \_\_\_\_\_

Sand \_\_\_\_\_

Drilling and Remarks:

Gas \_\_\_\_\_

Oil \_\_\_\_\_

Total Depth 3128

*Leas 3087*

*7" @ 3087*

PRODUCTION

1st 24 hrs. Nat. \_\_\_\_\_

1st 24 hrs. after shot \_\_\_\_\_

Gas \_\_\_\_\_ Cu. Ft.

Dry Hole \_\_\_\_\_

Abandoned \_\_\_\_\_

*5000 acid  
Pump 300 BX*

*38° SW*

Date

JUL 28 1943 19

S. J. LEWIS Scout