


KANSAS

DX 78-1 Graham

Section 34 Township 8 Range 24W

Well No. #1 Brown "C"

Company El Dorado Ref

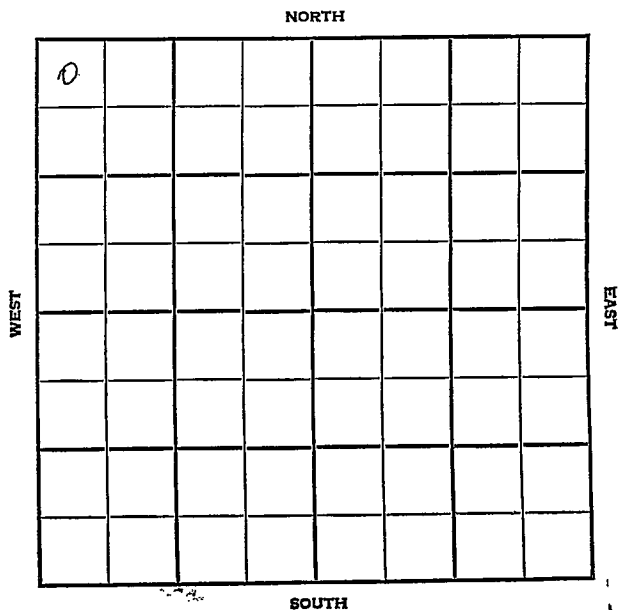

4

Graham

KANSAS

SEC.

34

TWP.

8

R.

24W

WELL NO.

#1 Brown "C"

FARM

COMPANY

El Dorado Ref.

CONTRACTOR

Prime Drlg.

Holley


____ FT. FROM N. LINE

____ FT. FROM S. LINE

____ FT. FROM E. LINE

____ FT. FROM W. LINE

NW NW NW

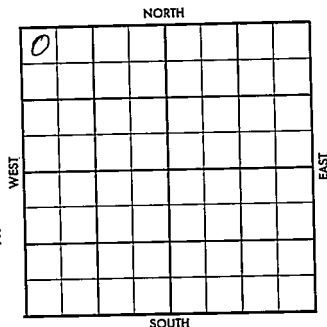

SDX - Offset

	ELEVATION	REPORT
1956	2424'	

8-15 Comm. 8-9-56
8" @ 288 w/210
Drlg. 2890

8-22 DST 3784-3805 op 30 min. rec. 55'
WGM, 1350/20".
D&A
H. 3721'; Tr. 3744'; L. 3761'
TD 3990'

ABANDONED

County Gram Elev. 2424
 Sec. 34 Twp. 8 Rgs. 24W
 Company El Dorado Ref.
 Farm Name Brown "C" No. 1

TOPS	DEPTH	LOG	DATUM	Loc. in Sec.
Anh.				NW NW NW
TP.				
H.				
Tr.				
Dg.				
BL.				
L.				Geol.
K.C.				Contr.
B.K.C.				Prime Drlg.
Ce.				
C.				Pool
M.				Holley
M.				
K.				
Mz.				
Me.				
V.				
S.				
S.				
A				
R.				
Pe.				
G.				
T.D.				

Date Comm. 8-9-56
8" @ 288/210 d rlg. 2890

AUG 15 '56

8001 2 S 211A

8001 2 S 211A

County Graham Elev. 2424
 Sec. 34 Twp. 8 Rge. 24W
 Company Colorado Ref.
Brown "C" No. 1

	DEPTH	LOG	DATUM	Loc. in Sec.
Anh.				NW NW NW
Top.				
H.	3721			
Tr.	3744			
Dg.				
Bl.				
L.	3761			Geol.
K.C.				Contr.
B.K.C.				Prime Drlg.
Ce.				
C.				
M.				
M.				Pool
K.				Holley
Mz.				
Mo.				
V.				
S.				
S.				
A.				
R.				
Pe.				
G.				
TD.	3990			

AUG 22 1956

Date Comm. 8-9-56

8" @ 288/210 drlg. 2890

AUG 22 56

DST 3784-3805 30" rel 55'

LOG M 1750/204

DEO