


Section 34 Township 8 Range 19W

Well No. #1 McCauley

Company Skelly

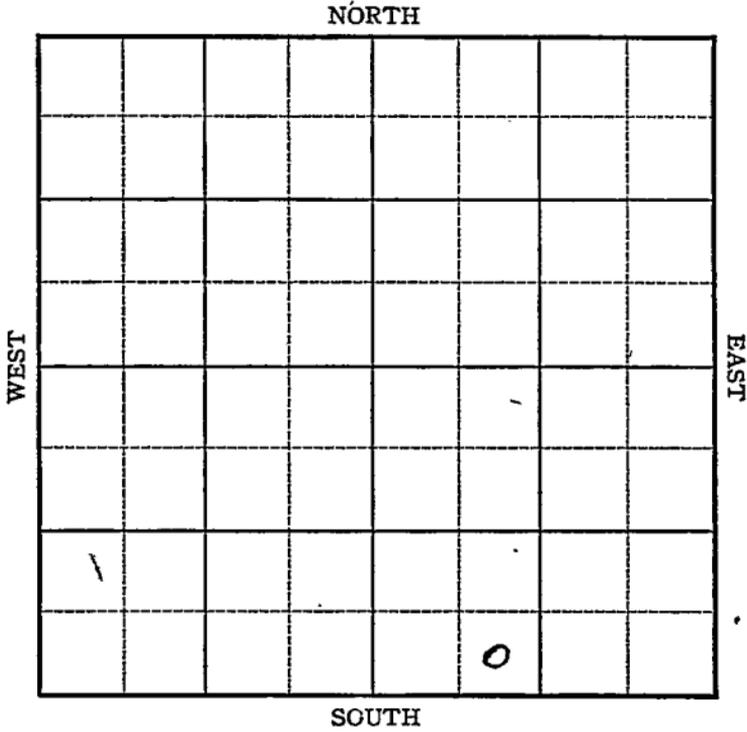

Sec. 34 Twp. 8 R. 19W

Well No. #1. McCauley Farm

Skelly Company


Webster

Ft. from N. Line

330 Ft. from S. Line

Ft. from E. Line

990 Ft. from W. Line

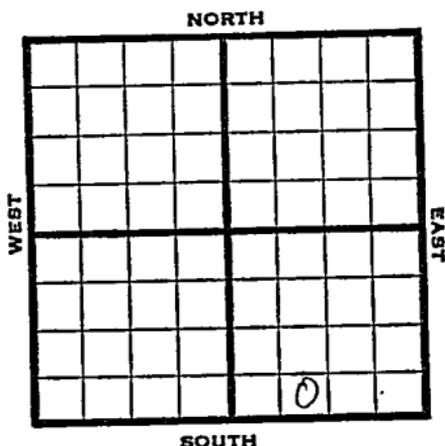

SE SW SE

1946 Elev. 2000' REPORT

4/24 RUR

4/30 13" @ 159
anhý 1440
8" @ 1446
WOC

5/7 Topeka 2970
Dodge 3190
SO 3190-93
Lans 3211
Drlg 3347

5/14 Cong 3476
Arb 3520-35 TD
5" @ 3521 RUST

5/21 PB 3498
60 shots 3392 $\frac{1}{2}$ -3401
72 shots 3380-88
3250 acid

5/29 Arb 3520'
5" @ 3521'
TD 3535'

ABANDONED

