
FORM 51 10M 12-46 PETROL KANSAS Rooks

Section 34 Township 8 Range 19W

Well No. 1 Ververka

Company D. R. Lauck

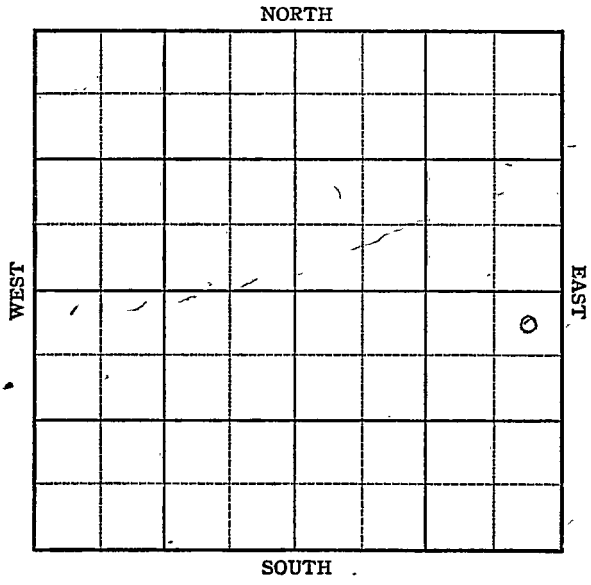

FORM 252-A
5M 12-46 PETROL

KANSAS

Rooks county

Sec. 34 Twp. 8 R. 19W

Well No. 1 Ververka Farm

D. R. Lauck Company

Ververka Pool


330 Ft. from N. Line

Ft. from S. Line

330 Ft. from E. Line

Ft. from W. Line

NE SE

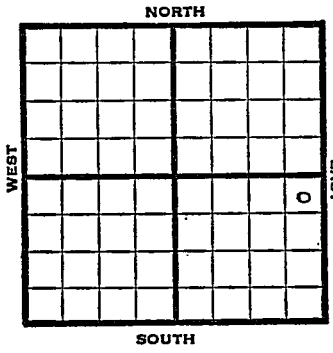


| 1947 | Elev. 2004' REPORT |
|---|---|
| 5/28 | Location |
| 6/3 | 10" @ 248 WOC |
| 6/10 | Drlg. 2710' |
| 6/18 | Lans. 3210'<br>Arb. 3538'<br>TD 3588' |
| | ABANDONED |

Form 26 200 Bks. 10-46 Petrol

Kansas

Ververka Pool

Map No. _____ Sec. 34 Twp. 8 R. 19W

Well No. 1 Ververka

D. R. Lauck Company

FIRST REPORT Contractor

NE SE


330 Ft. from N. Line

_____ Ft. from S. Line

330 Ft. from E. Line

_____ Ft. from W. Line

SECTION PLAT

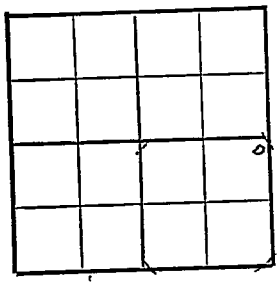

Rooks County

Location x

Rig up

Drilling and Remarks:

RECORD

Cased _____ in., _____ ft.

Sand

Gas

Oil

Total Depth

PRODUCTION

1st 24 hrs. Nat.

1st 24 hrs. after shot

Gas _____ Cu. Ft.

Dry Hole

Abandoned

Date

MAY 2 8 1947 19 S. J. LEWIS Scout

Form 26 200 Bks. 10-46 Petrol

Kansas

Ververka Pool

Map No. 65 Sec. 34 Twp. 8 R. 19W

Well No. 1 Ververka


D. R. Lauck Company

ABANDONED Contractor

NE SE

El. 2004

SECTION PLAT

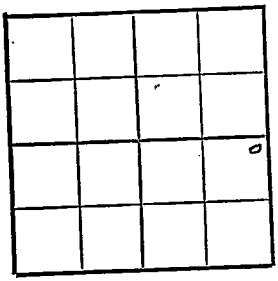

330 Ft. from N. Line

Ft. from S. Line

330 Ft. from E. Line

Ft. from W. Line

Rooks County

Location

Rig up

Drilling and Remarks:

Lans 3210

Arb 3388

RECORD

Cased in., ft.

Sand

Gas

Oil

Total Depth 3388

PRODUCTION

1st 24 hrs. Nat.

1st 24 hrs. after shot

Gas Cu. Ft.

Dry Hole

Abandoned

Date

JUN 18 1947 19

S. J. LEWIS Scout