


DX 78-1

Rooks KANSAS

Section 34 Township 8 Range 19W
Well No. 1 Berens
Company United Drlg.

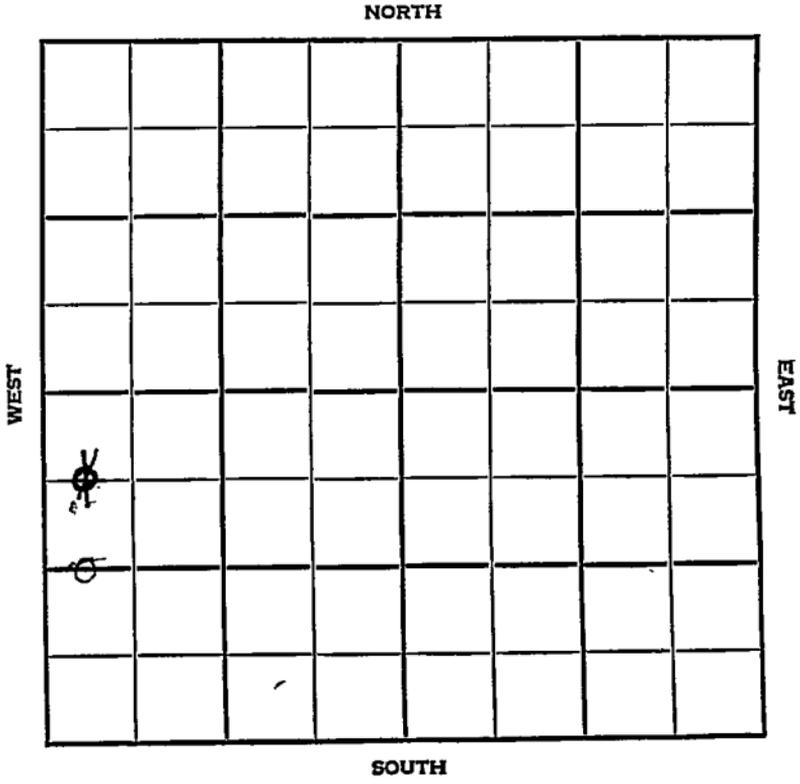

SEC. 34	TWP. 8	R. 19W	✓
------------	-----------	-----------	---

WELL NO. #1 Berens FARM

COMPANY United Drlg.

CONTRACTOR United Drlg.

Ververka Pool

~~1320~~
~~660~~


Ft. from N. Line

Ft. from S. Line

Ft. from E. Line

330

Ft. from W. Line

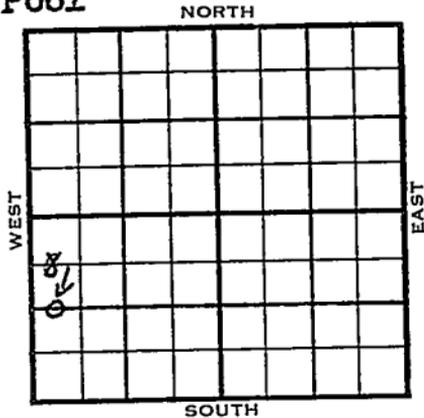

C W³/₂ NW SW

1954

ELEVATION

1978'

REPORT

5/26

Spud 5-25-54

8" @ 200'

WOC.

6/2

Drlg. 3290'

6/9

Spud 5-25-54

D & A

TD 3440

8" @ 200'

Heeb 3136

Tor. 3160

Lans. 3178

B KC 3360

Cong. 3394

Arb. 3425

TD 3440'

D & A

ABANDONED

Kansas

Map No. _____ Sec. 34 Twp. 8 R. 19W

Well No. 1 Berens

United Drlg. Company

CORRECTION Contractor

C $W\frac{1}{2}$ $W\frac{1}{2}$ SW

SECTION PLAT

1320 Ft. from N. Line

_____ Ft. from S. Line

_____ Ft. from E. Line

330 Ft. from W. Line

Rooks County

Location _____

Rig up _____

Drilling and Remarks:

Reported
C $W\frac{1}{2}$ NW SW

RECORD

Cased _____ in., _____ ft.

Sand _____

Gas _____

Oil _____

Total Depth _____

PRODUCTION

1st 24 hrs. Nat. _____

1st 24 hrs. after shot _____

Gas _____ Cu. Ft.

Dry Hole _____

Abandoned _____

Date

JUN 2 1954 19

J. G. McGEHEE

Scout

