


Section 34 Township 8 Range 19W

Well No. 1 Eaton Ververka Est.

Company Petroleum Inc. Ververka Pool

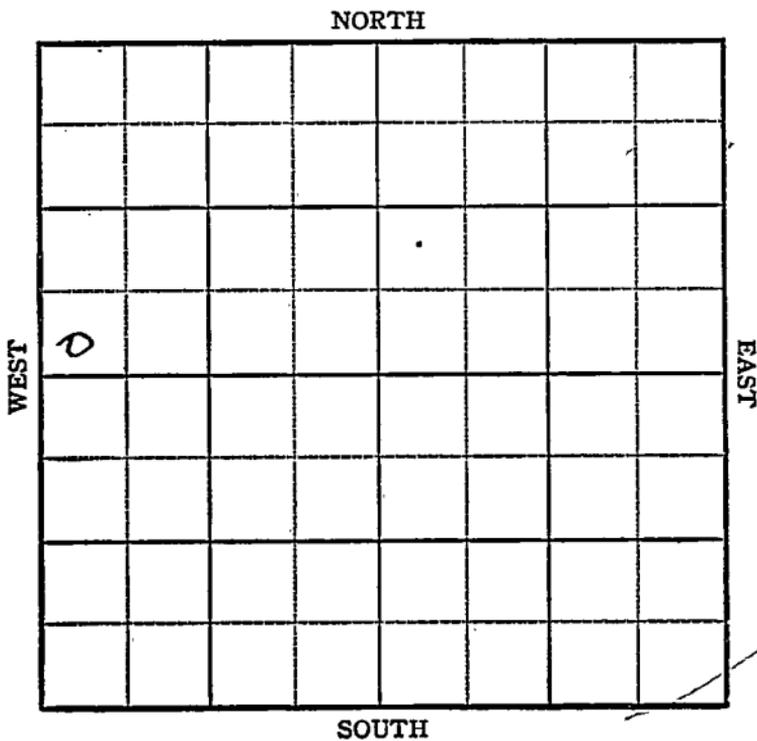

KANSAS Rooks

Sec. 34 Twp. 8 R. 19W ✓

Well No. ~~#1 Eaton~~ # Ververka Est. Farm

Petroleum, Inc. Company

Ververka Pool


         Ft. from N. Line

330' Ft. from S. Line

         Ft. from E. Line

330' Ft. from W. Line

SW NW

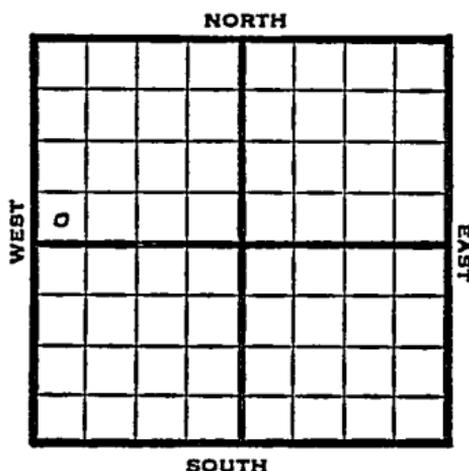

1948 Elev. 1955' REPORT

10/20	8" @ 250'
	Anhy. 1360'
	Drlg. 1400'
10/26	Lansing 3140'
	rlg 3245'
11/3	Arbuckle 3380'
	TD 3382'
	5" @ 3380'
11/10	TD 3384'
	Swb 60 bbls oil 2 hrs.
11/16	"
11/23	"
11/30	"
12/8	"
12/15	"
12/22	Arb 3380'
	5" @ 3382'
	Echo Pot. 2399 oil & 14% W
	Gr. 28°
	TD 3384'

**COMPLETED**

Map No. \_\_\_\_\_ Sec. 34 Twp. 8 R. 19W

Well No. 1 Eaton

Petroleum Inc. Company

**FIRST REPORT**

Contractor

SW NW


**SECTION PLAT**

\_\_\_\_\_ Ft. from N. Line

330 Ft. from S. Line

\_\_\_\_\_ Ft. from E. Line

330 Ft. from W. Line

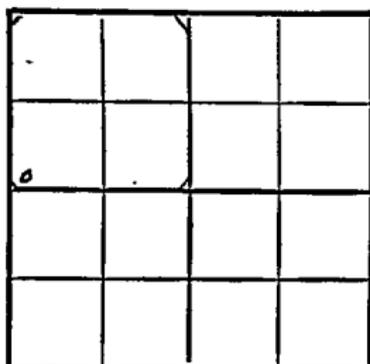

Rooks County

Location \_\_\_\_\_

Rig up \_\_\_\_\_

Drilling and Remarks:

8" @ 250  
Anhy 1360  
drlg. 1400

**RECORD**

Cased \_\_\_\_\_ in., \_\_\_\_\_ ft.

Sand \_\_\_\_\_

Gas \_\_\_\_\_

Oil \_\_\_\_\_

Total Depth \_\_\_\_\_

**PRODUCTION**

1st 24 hrs. Nat. \_\_\_\_\_

1st 24 hrs. after shot \_\_\_\_\_

Gas \_\_\_\_\_ Cu. Ft.

Dry Hole \_\_\_\_\_

Abandoned \_\_\_\_\_

Date

OCT 20 1948 19

S. I. LEWIS Scout



