


Section 34 Township 8 Range 19W

Well No. 2 Ververka

Company Petroleum Inc.

Webster Pool  
NORTH

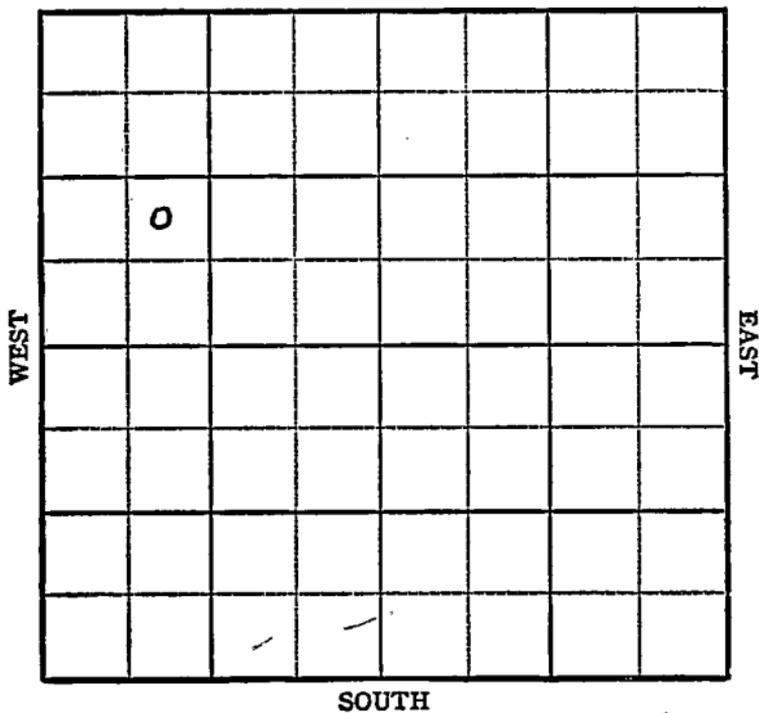

Sec. 34 Twp. 8 R. 19-W

Well No. #2 Ververka Farm

Petroleum Inc.

Webster Company

Company


\_\_\_\_\_ Ft. from N. Line

990 Ft. from S. Line

\_\_\_\_\_ Ft. from E. Line

880 Ft. from W. Line

NE SW NW

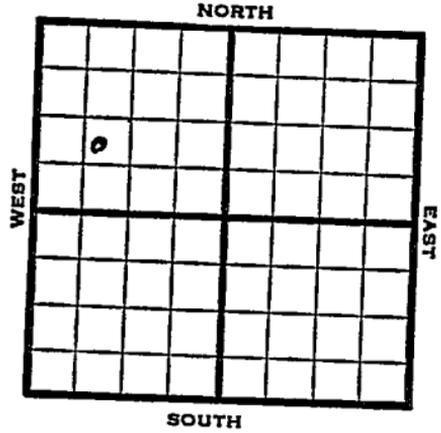

1948

Elev 1953' REPORT

12/22

Location

12/29

RUR

1/5

8" @ 248'  
Drig. 2000'

1/12

Lansing 3156 Drig. 3200

1/19

Arb. 3392-99'  
TD 3399'  
5" @ 3392'

1/26

"

2/2

850 acid

2/9

Swb  $2\frac{1}{4}$  bbls oil /  $\frac{1}{4}$  W PH 4 hrs.

2/16

"

2/23

"

3/2

TD 3399'  
Arb. 3392'  
5" @ 3392'  
850 acid  
Pump 25 oil / 18% W Pot  
27° Gr.

Comp

**COMPLETED**

Map No. \_\_\_\_\_ Sec. 34 Twp. 8 R. 19WWell No. 2 Ververka\_\_\_\_\_  
Petroleum Inc. \_\_\_\_\_ Company**FIRST REPORT** \_\_\_\_\_ ContractorNE SW *NW***SECTION PLAT**

o			
c			

\_\_\_\_\_  
Ft. from N. Line990  
Ft. from S. Line\_\_\_\_\_  
Ft. from E. Line880  
Ft. from W. Line

Rooks County

Location \_\_\_\_\_ X

Rig up \_\_\_\_\_

Drilling and Remarks:

**RECORD**

Cased \_\_\_\_\_ in., \_\_\_\_\_ ft.

Sand \_\_\_\_\_

Gas \_\_\_\_\_

Oil \_\_\_\_\_

Total Depth \_\_\_\_\_

**PRODUCTION**

1st 24 hrs: Nat. \_\_\_\_\_

1st 24 hrs. after shot \_\_\_\_\_

Gas \_\_\_\_\_ Cu. Ft.

Dry Hole \_\_\_\_\_

Abandoned \_\_\_\_\_

Date

DEC 22 1948 19S. J. LEWIS

Scout

