


Map No. **KANSAS** Sec. 34 Twp. 8^S / 1^W R. 1^WWell No. 1 - Burnley Farm
Hanson O & G Company

NORTH

WEST

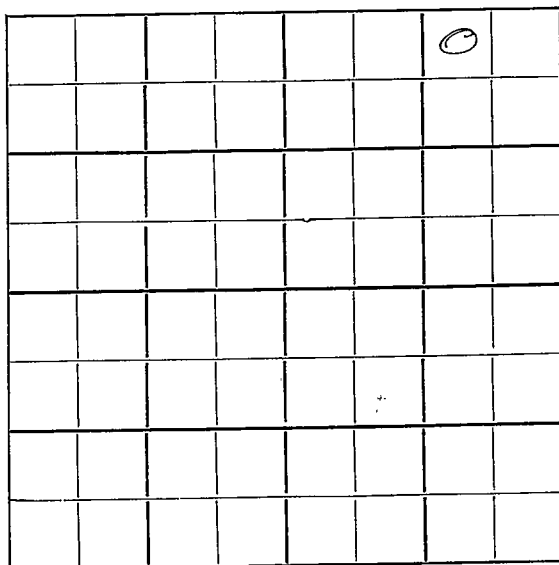

EAST

SOUTH

Location.....

Drilling Remarks

Rig Up.....

Drilling Remarks

RECORD

Cased.....in.....ft.

Sand.....

Gas.....

Oil.....

Total Depth.....

PRODUCTION

1st 24 hrs. Nat.....

1st 24 hrs. after shot.....

Gas.....cu. ft.....

Dry Hole.....

Abandoned.....

Map No. Sec. Twp. R.

Well No. Farm


..... Company

..... Ft. from N. Line

..... Ft. from S. Line

..... Ft. from E. Line

..... Ft. from W. Line

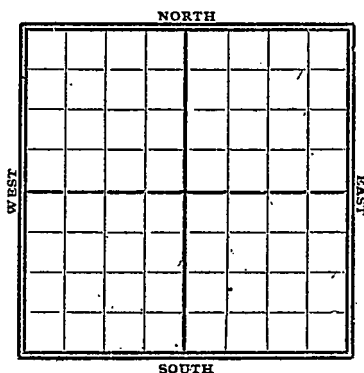

1923

Date

REPORT

Gypsy Records

1/27

Abd T'D 1550'

85

 MAP NO. _____ SEC. 34 TWP. 82 R. 1W
WELL NO. 1 BurnerNational Oil & Gas Co. COMPANY_____
no well info CONTRACTOR

SECTION PLAT

			0

Ft. FROM N. LINE_____
Ft. FROM S. LINE_____
Ft. FROM E. LINE_____
Ft. FROM W. LINE

LOCATION _____

RIG UP _____

DRILLING AND REMARKS:

*Rig Blown
down*

RECORD

CASED _____ IN. _____ FT.

SAND _____

GAS _____

OIL _____

TOTAL DEPTH 1550

PRODUCTION

1ST 24 HRS. NAT. _____

1ST 24 HRS. AFTER SHOT _____

GAS _____ Cu. Ft.

DRY HOLE ☒ABANDONED ☒

DATE

1/27 192 31 SCOUT