

Section 34 Township 8 Range 26 WWell No. # 1 SengerCompany Harper-Turner

NORTH

			0				

WEST

EAST

SOUTH

3

Sheridan KANSAS

Sec. 34 Twp. 8 R. 26 W

Well No. # 1 Senger Farm

Harper-Turner Company

Musgrove Contractor
Wildcat


330 Ft. from N. Line

Ft. from S. Line

330 Ft. from E. Line

Ft. from W. Line

NE NE NW

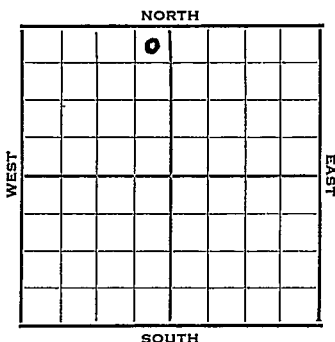

1952

Elev. 2542 REPORT

9/4

Spud 8-26-52
8" @ 172' Lans. 3710'
Drlg. 3905'

9/10

Spud 8-26-52
D&A TD 4438
8" @ 172 Heeb. 3668 Tor. 3688
Lans. 3703 Marm. 3934 Cong sh 4208
Cherty Congl 4217 Miss Ch. 4223
Miss Lime 4256 Viola 4348 Simp 4372
Arb. 4380 TD 4438 D&A

ABANDONED

County Sheridan State Kansas
 Sec. 34 (Blk.) 8 (Sur.) 26W Map No.
 Operator Harper - Turner
 Well No. 1 Farm Senger
 Elev. _____ Location NE NE NW

			0			

FIRST REPORT

330 Ft. From N Line NW
330 Ft. From E Line Quarter
 Ist. Report SEP 4 1952

Completion _____

Remarks _____

Musgrove - Contr.


Spudding Date 8-26-52

Drlg. Data _____

Wildcat

8" @ 172 lans. 3710 drlg. 3905

County Sheridan State Kansas
 Sec. 34 (Blk.) 8 (Sur.) 26W Map No. 1
 Operator Harper - Turner
 Well No. 1 Farm Senger
 Elev. 2542 Location NE NE NW

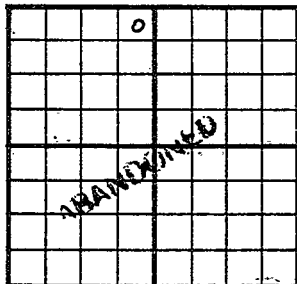

330 Ft. From N Line NW
330 Ft. From E Line Quarter
 Ist. Report SEP 10 1952
 Completion SEP 10 1952
 Remarks Wildcat
Musgrove - Contr.
 Spudding Date 8-26-52

Drlg. Data D & A TD 4438
8" @ 172 Heeb. 3668 Tor. 3688
Lans. 3703 Marm. 3934 Cong. sh. 4208
Cherty Cong. 4217 Miss. ch. 4223
Miss. lime 4256 Viola 4348 Simp. 4372
Arb. 4380 TD 4438

D & A

J. G. McGEHEE
 McGEHEE