



Graham

KANSAS

Sec. 35 Twp. 8 R. 25W

Well No. #1 Reichmeier Farm

Mammoth Oil Company


Field - Contr. Contractor  
Wildcat

\_\_\_\_\_ Ft. from N. Line

330' Ft. from S. Line

\_\_\_\_\_ Ft. from E. Line

990' Ft. from W. Line

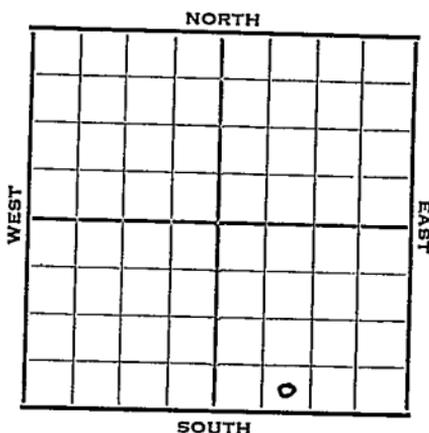

SE SW SE

1952

Elev. 2506' REPORT

3/19

MIR

3/25

8" @ 224'

Drlg. 3000'

4/1

DST 3876-3930, 1 hr. 220' m  
1325#

DST 3976-4025, 45 mins. 30' m

Drlg. ahead

4/9

Spud 3-20-52

D&A TD 4600

8" @ 224 DST 3875-3930 open

lr. rec. 220' mud

DST 3976-4025 open 45 min.

rec. 30' mud

Anhy 2206

Lans. 3826

Miss. 4346

Viola 4479

Arb. 4548

TD 4600 D&A

**ABANDONED**



