

KANSAS

Rooks

Section 35 Township 8 Range 19WWell No. 1 SlanskyCompany Harry GoreWildcat
NORTH

WEST

				0			

EAST

SOUTH

KANSAS

Rooks



Sec. 35 Twp. 8 R. 19W

Well No. #1 Slansky Farm

Harry Gore Company


Wildcat

330' Ft. from N. Line

 Ft. from S. Line

 Ft. from E. Line

330' Ft. from W. Line

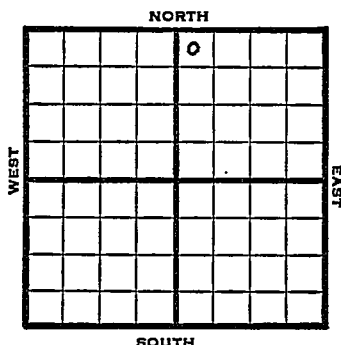

NW NE

1949

Elev 1980' REPORT

4/20

8" @ 190'

4/27

Lansing 3185'

Drlg 3250'

5/4

TD 3520'

Arb. 3460'

Aband.

ABANDONED

Map No. _____ Sec. 35 Twp. 8 R. 19W

Well No. 1 Slansky

Harry Gore Company

FIRST REPORT

Contractor

NW NE


SECTION PLAT

330 Ft. from N. Line

_____ Ft. from S. Line

_____ Ft. from E. Line

330 Ft. from W. Line

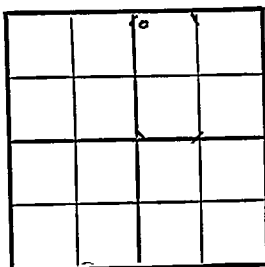

Rooks County

Location _____

Rig up _____

Drilling and Remarks: _____

8" @ 190

RECORD

Cased _____ in., _____ ft.

Sand _____

Gas _____

Oil _____

Total Depth _____

PRODUCTION

1st 24 hrs. Nat. _____

1st 24 hrs. after shot _____

Gas _____ Cu. Ft.

Dry Hole _____

Abandoned _____

Date

APR 20 1949

19

S. J. LEWIS Scout

Map No. K-65 Sec. 35 Twp. 8 R. 19W

Well No. 1 Slansky

Harry Gore

Company

ABANDONED

Contractor

NW NE


E. 1. 1980
SECTION PLAT

330 Ft. from N. Line

_____ Ft. from S. Line

_____ Ft. from E. Line

330 Ft. from W. Line

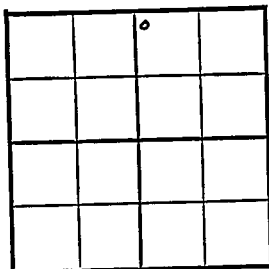

Rooks County

Location _____

Rig up _____

Drilling and Remarks:

Cr 3460

RECORD

Cased _____ in., _____ ft.

Sand _____

Gas _____

Oil _____

Total Depth 2150

PRODUCTION

1st 24 hrs. Nat. _____

1st 24 hrs. after shot _____

Gas _____

Cu. Ft.

Dry Hole _____

Abandoned _____

Date

MAY 4 1949 19

S. J. LEWIS

Scout