


Section 35 Township 8 Range 19 W

Well No. # 1 Slansky

Company Strain Drlg. et al

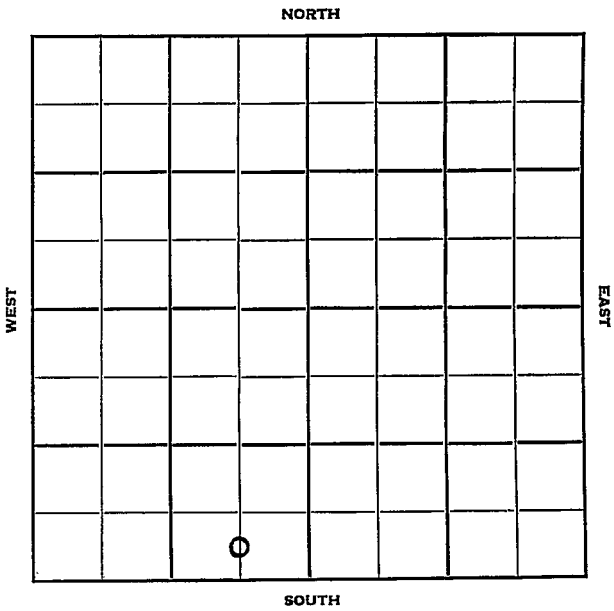

Sec. 35 Twp. 8 R. 19 W ✓

Well No. # 1 Slansky Farm

Strain Drlg. et al Company

Strain Drlg. Contractor


\_\_\_\_\_ Ft. from N. Line

330 Ft. from S. Line

660 Ft. from E. Line

\_\_\_\_\_ Ft. from W. Line

C S L SE SW

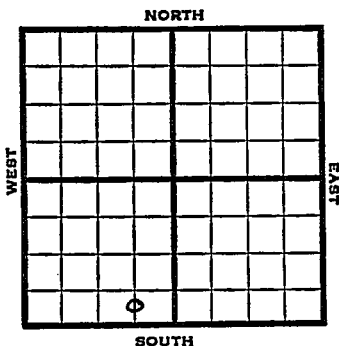

1951

Elev. 1964' REPORT

3/7

Spud 3-2-51  
8" @ 130  
Anhy 1365  
Drlg. 2180'

5/23

Spud 3-2-51  
Oil well TD 3409' 8" @ 130'  
Anhy 1365' Heeb 3111' Lans. 3151'  
Arb. 3402'  
DST 3404-09' open  $\frac{1}{2}$  hr. rec 251' free  
oil, 60' OCM 5" @ 3404' TD 3409'  
S/ 21 BO 3 hrs. FU 2400' oil  
Comp. 104 BOPD

**COMPLETED**



