


Section 35 Township 8 Range 19W

Well No. #2 Slansky

Company Harry Gore

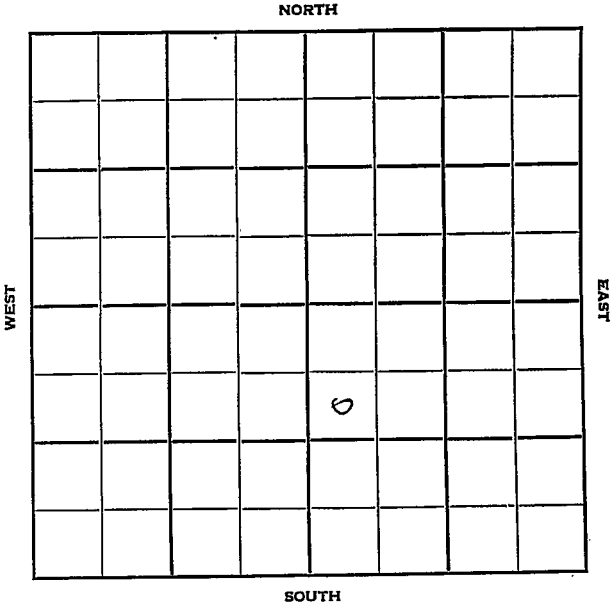

Rooks

KANSAS

Sec. 35 Twp. 8 R. 19 W ✓

Well No. # 2 Slansky Farm

Harry Gore Company

Strain Drlg. Contractor

Berry Pool


990 Ft. from N. Line

 Ft. from S. Line

 Ft. from E. Line

330 Ft. from W. Line

SW NW SE

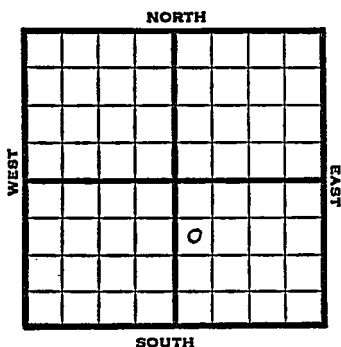

1951

Elev. 1973'

REPORT

4/4

R U R


4/18

Spud 4-3-51


D & A TD 3490'

8" @ 153 Anhy 1410', Top. 2943',
Heeb. 3154', Dodge 3172', Lans 3189
B KC 3419', Cong 3455', Arb. 3484'
TD 3490' D & A

ABANDONED

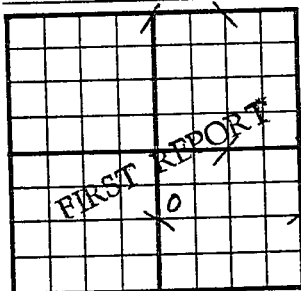County Rooks State KansasSec. 35 (Blk. 8 (Sur. 19W Map No. 8)
(Twp.)Operator Harry GoreWell No. 2 Farm SlanskyElev. Location SW NW SE990 Ft. From N Line SE330 Ft. From N Line Quarter1st. Report APR 4 1951Completion Remarks Strain Drlg. - Contr.Spudding Date Drlg. Data Berry PoolR U R

County Rooks State Kansas
 Sec. 35 (Blk. 8 (Sur. 19W Map No.)
 Operator Harry Gore
 Well No. 2 Farm Slansky
 Elev. 1973 Location SW NW SE

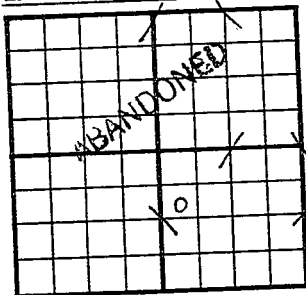

990 Ft. From N Line SE
330 Ft. From W Line Quarter
 Ist. Report
 Completion APR 18 1951
 Remarks Berry Pool
Strain Drlg. - Contr.
 Spudding Date 4-3-51

Drlg. Data D & A TD 3490
8" @ 153 Anhy 1410 Top. 2943
Heeb. 3154 Dodge 3172 Lans. 3189
B KC 3419 Cong. 3455 Arb. 3484 TD 3490
D & A

J. E. TYRA