FORM 51 25M 3-49 PETROL


Rooks

KANSAS

Section 35 Township 8 Range 19 W

Well No. # 2 Salansky

Company Strain Drlg.

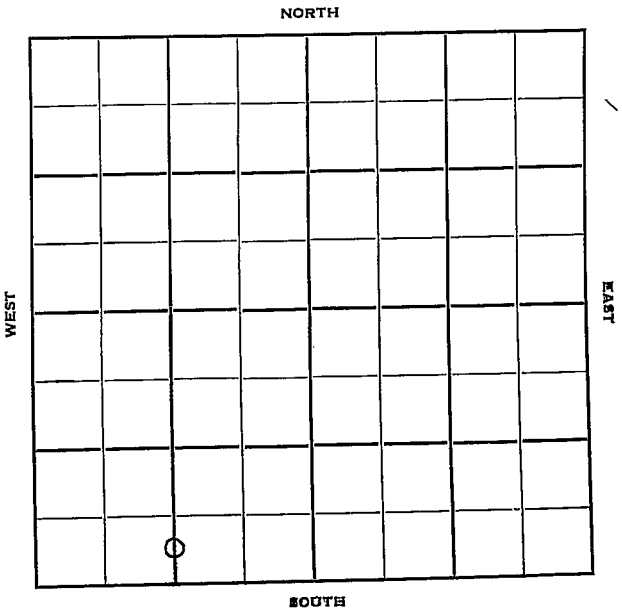

FORM 252-B
10M 10-50 PETROL

Rooks KANSAS

Sec. 35 Twp. 8 R. 19 W

Well No. # 2 Salansky Farm

Strain Drlg. Company

Contractor

Barry


Ft. from N. Line

330 Ft. from S. Line

Ft. from E. Line

1320 Ft. from W. Line

C S/2 S/2 SW

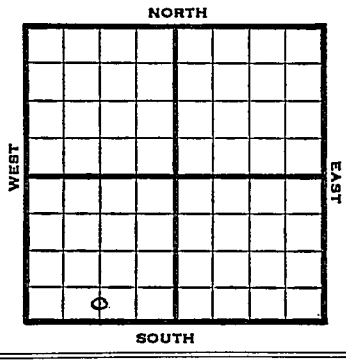

1951	Elev. 1983' REPORT
10/17	Drilling
11/21	Spud 10-10-51 Oil well TD 3440' 8" @ 185 Anhy 1390' DST 3272 open 1 hr. rec 120' mud DST 3340-86 open 1 hr. rec 54' HO & GCM Top 2926' Heeb 3136' Lans. 3174' Arb. 3425' DST 3427-32 open ½ hr. rec 5' mud DST 3427-40 open 1 hr. rec 60' OCM 5" @ 3427' CO to 3440' 500 A P/50 BOPD for 2 days. Comp. 39 BOPD COMPLETED

FORM 275 FOR SALE BY KANSAS BLUE PRINT CO.

County Rooks State Kansas

Sec. 35 (Blk. Twp.) 8 (Sur. Rge.) 19W Map No.

Operator Strain Drlg.

Well No. 2 Farm Salansky

Elev. Location C S/2 S/2 SW



330 Ft. From S Line SW

1320 Ft. From W Line Quarter

1st. Report OCT 17 1951

Completion

Remarks

Spudding Date

Drlg. Data Barry

Drlg.

J. E. TYRA

FORM 275 FOR SALE BY KANSAS BLUE PRINT CO.


County Rooks State Kansas

Sec. 35 (Blk. Twp.) 8 (Sur. Rge.) 19W Map No.

Operator Strain Drlg.

Well No. 2 Farm Salansky

Elev. 1983 Location C S L S½ SW

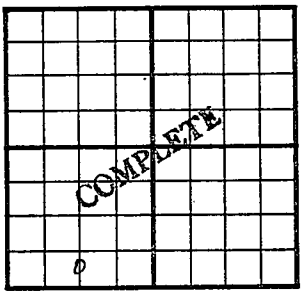

330 Ft. From S Line SW

1320 Ft. From W Line Quarter

1st. Report

Completion NOV 21 1951

Remarks Berry Pool

Spudding Date 10-10-51

Drlg. Data Oil well TD 3440

8" @ 185 Anhy 1390 DST 3272 open 1 hr.

Rec. 120' mud DST 3340-86 open 1 hr.

Rec. 54' ho & gcm Top. 2926 Heeb. 3136

Lans. 3174 Arb. 3425 DST3427-32

open ½ hr. Rec. 5' mud DST 3427-40

open 1 hr. Rec. 60' ocm 5" @ 3427

CO to 3440 500 A P/ 50 bopd for 2 days

Comp. 39 bopd

J. E. TYRA