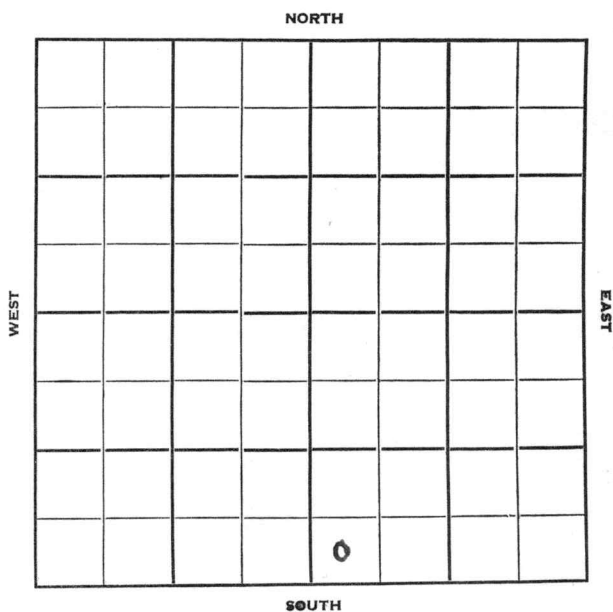


Section 35 Township 8 Range 27 WWell No. # 1 HarrisCompany Carl Todd

15

Sheridan

KANSAS

Sec. 35 Twp. 8 R. 27W

Well No. #1 Harris Farm

Carl Todd Company

Contractor


Ft. from N. Line

330' Ft. from S. Line

Ft. from E. Line

330' Ft. from W. Line

SW SW SE

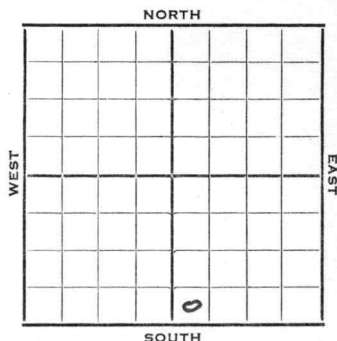

1952 Elev. 2620' REPORT

6/4 Location

6/11 Heeb. 3738 Lans. 3776

Drlg. 4097'

6/18 Spud 5-30-52

D&A TD 4365' 8" @ 252'

Heeb. 3738 Lans. 3776

B KC 4006 Marm. 4030

Miss. 4327

TD 4365' D&A

ABANDONED

County **Sheridan** State **Kansas**

Sec. **35** (Bk. **8**) (Sur. **27W**) Map No.

Operator **Carl Todd**

Well No. **1** Farm **Harris**

Elev.	Location	SW SW SE
-------	----------	----------

330 Ft. From S Line SE

330 Ft. From W Line Quarter

1st. Report **JUN 4 1952**

Completion


Remarks

Spudding Date _____

Drlg. Data

Location

J. G. McGEHEE

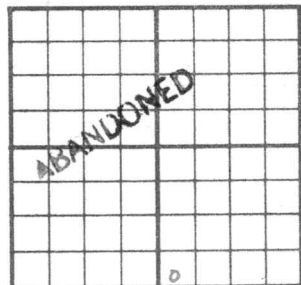County Sheridan State KansasSec. 35 (Blk.
Twp.) 8 (Sur.
Rge.) 27W Map No.Operator Carl ToddWell No. 1 Farm HarrisElev. 2620 Location SW SW SE330 Ft. From S Line SE330 Ft. From W Line QuarterIst. ReportCompletion JUN 18 1952RemarksSpudding Date 5-30-52Drlg. Data D & A TD 43658" @ 252 Heeb. 3738 Lans. 3776B KC 4006 Marm. 4030 Miss. 4327TD 4365 D & A

J. G. McGEHEE