KANSAS

Form 51—5M—7-40—Palace


Rooks

Section 36 Township 8- Range 18-W

Well No. #1 Maddy

Company ~~K. A. Nil~~ Sharon Drilling

Dopita Pool

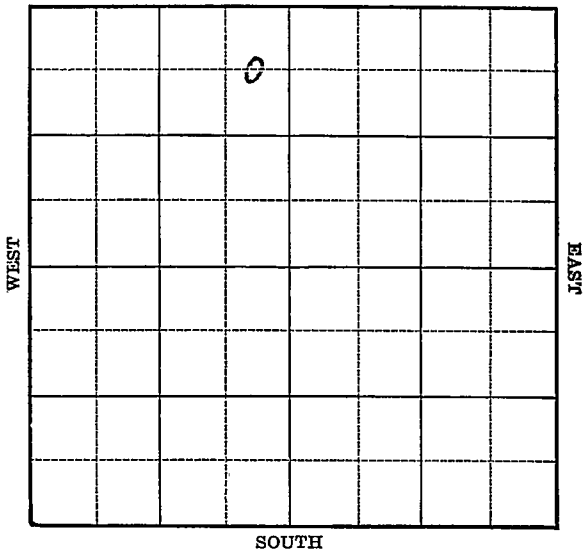

FORM 252-A 5M 7-40 PETROL KANSAS Rooks

Sec. 36 Twp. 8 R. 18-W

Well No. #1 Maddy Farm

~~K. A. Nil~~ Sharon Drilling Company


(Dopita)

660 Ft. from N. Line

Ft. from S. Line

330 Ft. from E. Line

Ft. from W. Line

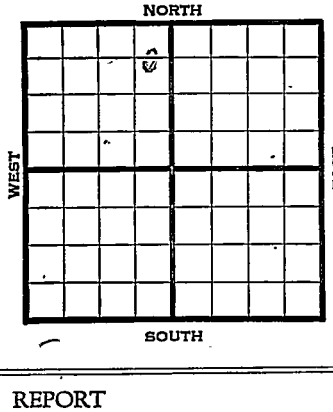

1941	REPORT
1/8	Spud 40' SD.
1/16	" "
1/23	" "
1/30	" "
2/6	" "
2/13	8" - 60' Anhy 1300'
	Drlg. 1365'
2/20	Drlg. 2455'
2/27	Lans. 3158' Arb. 3436-38' T.D.
	Run csg.
3/6	5" - 3438' WOC.
3/13	Shut down.
3/20	T.D. 3527' 500 acid.
	Shut down.
3/27	" "
4/3	" "
4/10	" "
	OVER

105

1941

4/18 Swab 19½ bbls. fluid 5 hours, 6% water. 1000 acid. Swab 33 bbls. 10 hours, 15% water.

4/24 Shut down.

5/2 " "

5/8 " "

5/15 " "

5/22 " "

5/27 Lans. 3158'
5" - 3438'
T.D. 3528½'
P.B. to 3425'
84 shots 3373-3401'
2500 acid.
Potential 105 bbls., pump.
36.5 Gravity

COMPLETED

Form 26—200 Bks.—1-40—Palace Rooks KANSAS

Map No. 64 Sec. 36 Twp. 8 R. 18W


Well No. 1 Maddy

K. A. Nil Company

Contractor

FIRST REPORT

SECTION PLAT

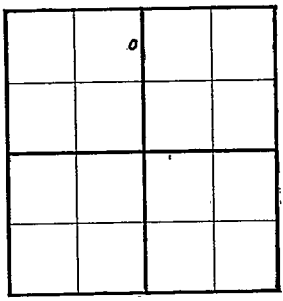

C E L NE NW

660 Ft. from N. Line

Ft. from S. Line

330 Ft. from E. Line

Ft. from W. Line

DOPITA POOL

Location

Rig up

Drilling and Remarks:

Spud 40' S.D.

RECORD

Cased in., ft.

Sand

Gas

Oil

Total Depth

PRODUCTION

1st 24 hrs. Nat.

1st 24 hrs. after shot

Gas Cu. Ft.

Dry Hole

Abandoned

Date

JAN 8 1941 19

S. J. LEWIS Scout

Form 26—200 Bks.—1-40—Palace Rooks KANSAS

Map No. 64 Sec. 36 Twp. 8 R. 18W

Well No. 1 Maddy

Sharon Drilling Company

CORRECTION Contractor

C E L NE NW

660 Ft. from N. Line


_____ Ft. from S. Line

330 Ft. from E. Line

_____ Ft. from W. Line

DOPITA POOL

SECTION PLAT

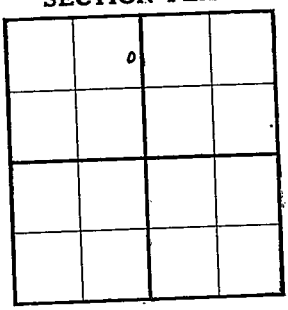

Location _____

Rig up _____

Drilling and Remarks:

Reported as

K. A. Nil

RECORD

Cased _____ in., _____ ft.

Sand _____

Gas _____

Oil _____

Total Depth _____

PRODUCTION

1st 24 hrs. Nat. _____

1st 24 hrs. after shot _____

Gas _____ Cu. Ft.

Dry Hole _____

Abandoned _____

Date

FEB 12 1941 19____

S. J. LEWIS Scout

Form 26—200 Bks.—1-40—Palace Rooks KANSAS

Map No. 64 Sec. 36 Twp. 8 R. 18W

Well No. 1 Maddy

Sharon Drilling Company

COMPLETED Contractor

C E L NE NW

660 Ft. from N. Line


_____ Ft. from S. Line

330 Ft. from E. Line

_____ Ft. from W. Line

DOPITA POOL

SECTION PLAT

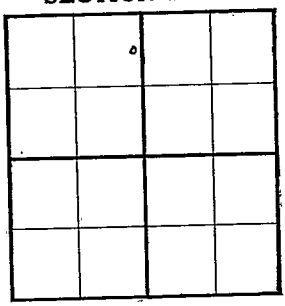

Location _____

Rig up _____

Drilling and Remarks:

Lime 3157.
5" @ 3438.
PB 3425.
SH Shots 3373-3401
2500 gal. C
Pump 105 Bbl.
365 Gr.

RECORD

Cased _____ in., _____ ft.

Sand _____

Gas _____

Oil _____

Total Depth 3528½

PRODUCTION

1st 24 hrs. Nat. _____

1st 24 hrs. after shot _____

Gas _____ Cu. Ft.

Dry Hole _____

Abandoned _____

Date

MAY 27 1941 19 S. J. LEWIS Scout

Please check depth of shots.

Paul.

