

KANSAS


Rooks

KANSAS

Section 36 Township 8 Range 18-W

Well No. #4 Maddy

Company Bill Graham
Dopita Pool

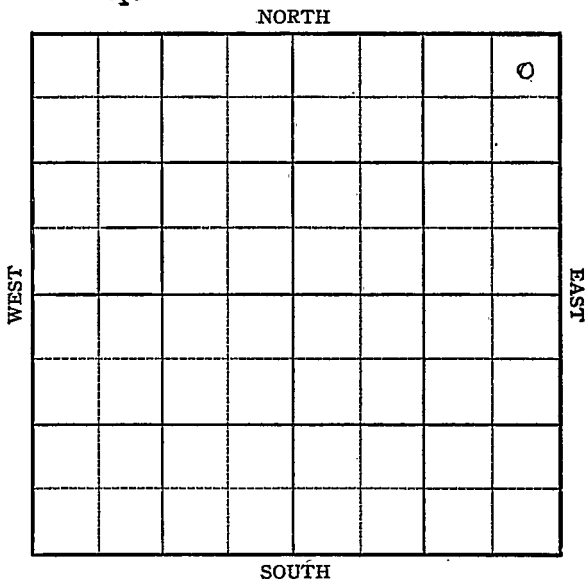

Rooks KANSAS

Sec. 36 Twp. 8 R. 18W

Well No. #4 Maddy Farm

Bill Graham Company
Dopita Pool (Graham, Contr.)


330' Ft. from N. Line

Ft. from S. Line

330' Ft. from E. Line

Ft. from W. Line

NE/C

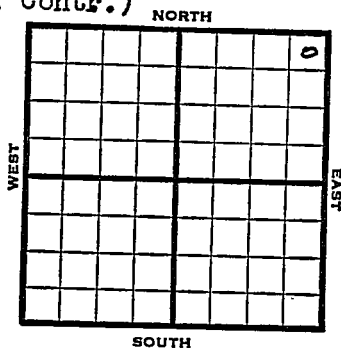

1949 Elev. 1992' REPORT

11/16 RUR
11/23 8" @ 165'
Topeka 3010'
Drlg 3149'
11/29 Arb. 3412
5" @ 3415'
TD 3421'
1000 acid
Swb 8 bbls oil PH 9 hrs.
12/7 "
12/14 Arb 3412'
5" @ 3415'
Acid 1000
Pump 60 oil Pot.
TD 3421'

COMPLETED

Kansas

Map No. _____ Sec. 36 Twp. 8 R. 18W

Well No. 4 Maddy

Bill Graham Company

Graham Contractor

NE/C

FIRST REPORT
SECTION PLAT


330 Ft. from N. Line

Ft. from S. Line

330 Ft. from E. Line

Ft. from W. Line

Rooks County

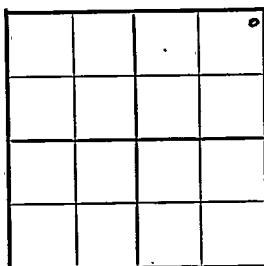

RECORD

Location _____

Cased _____ in., _____ ft.

Rig up _____

Sand _____

Drilling and Remarks: _____

Gas _____

Oil _____

R U R

Total Depth _____

PRODUCTION

1st 24 hrs. Nat. _____

1st 24 hrs. after shot _____

Gas _____ Cu. Ft.

Dry Hole _____

Abandoned _____

Date

NOV 16 1949 19

S. J. LEWIS

Scout

Dopita Pool

Kansas

8- 18W

Map No. _____ Sec. 36 Twp. _____ R. _____

Well No. 4 Maddy _____

Bill Graham _____ Company

COMPLETE _____ Contractor

NE/C

F11992
SECTION PLAT

330 Ft. from N. Line

_____ Ft. from S. Line

330 Ft. from E. Line

_____ Ft. from W. Line

			e

Rooks County

Location _____

Rig up _____

Drilling and Remarks:

Cen 8 3413

5" @ 3415

10000000

Pump 60 oil 808

27 2 1/2

RECORD

Cased _____ in., _____ ft.

Sand _____

Gas _____

Oil _____

Total Depth 3421

PRODUCTION

1st 24 hrs. Nat. _____

1st 24 hrs. after shot _____

Gas _____ Cu. Ft.

Dry Hole _____

Abandoned _____

Date

DEC 14 1949 19

S. J. LEWIS Scout