


Section 36 Township 8 Range 18W

Well No. 1 Modey

Company Bill Graham

Dopita Pool
NORTH

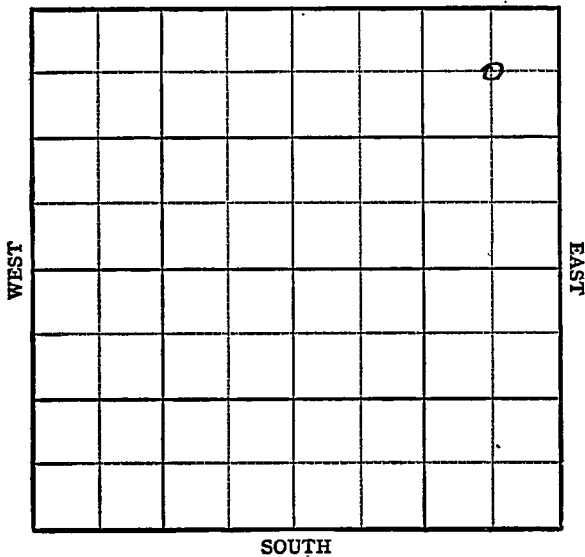

Sec. 36 Twp. 8 R. 18W ✓

Well No. #1 Modey Farm

Bill Graham

Company

Dopita Pool


660' Ft. from N. Line

_____ Ft. from S. Line

660' Ft. from E. Line

_____ Ft. from W. Line

C NE NE

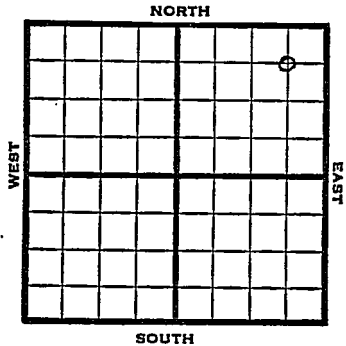

1948

Elev. 1978' REPORT

12/15

Surface Hole

12/22

8" @ 135'

Drlg 2130'

12/29

Lansing 3142'

Arbuckle 3403-107'

TD 3407'

1/5

Run csg.
5" @ 3402'

1/12

"

1/19

"

1/26

Arbuckle 3403'

5" @ 3402'

500 acid

Pump 30 oil Pot.

Gr. 27°

TD 3410'

COMPLETED

Map No. _____ Sec. 36 Twp. 8 R. 18W

Well No. 1 Modey

Bill Graham Company

FIRST REPORT Contractor

C NE NE

SECTION PLAT

			o

660 Ft. from N. Line

_____ Ft. from S. Line

660 Ft. from E. Line

_____ Ft. from W. Line

Rooks County

RECORD

Location _____

Cased _____ in., _____ ft.

Rig up _____

Sand _____

Drilling and Remarks:

Gas _____

surface hole

Oil _____

Total Depth _____

PRODUCTION

1st 24 hrs. Nat. _____

1st 24 hrs. after shot _____

Gas _____ Cu. Ft.

Dry Hole _____

Abandoned _____

Date

DEC 15 1948 19

S. J. LEWIS Scout

Map No. 64 Sec. 36 Twp. 8 R. 18W

Well No. 1 Modey

Bill Graham Company

COMPLETE

Contractor

C NE NE

E11978

SECTION PLAT

			0

660 Ft. from N. Line

 Ft. from S. Line

660 Ft. from E. Line

 Ft. from W. Line

Rooks County

RECORD

Location

Cased in., ft.

Rig up

Sand

Drilling and Remarks:

Gas

Oil

Total Depth 3410

Cor 3403
5" Cor 3402
5000 cu'
Pump 30 oil P.D.
37 e/b

PRODUCTION

1st 24 hrs. Nat.

1st 24 hrs. after shot

Gas Cu. Ft.

Dry Hole

Abandoned

Date

JAN 26 1949

19

S. J. LEWIS

Scout