DX 78-1

Graham


KANSAS

Section 36 Township 8 Range 25W

Schlumberger

Well No. #1 W. L. Bell

Company Il W. Seigle

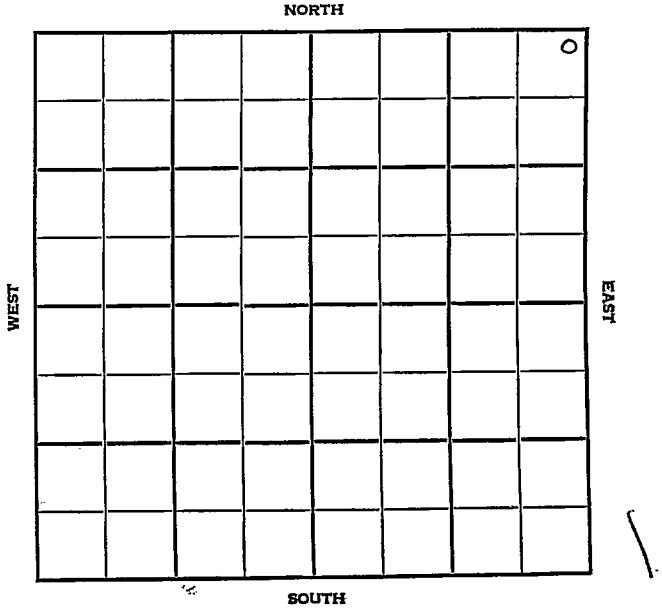

Graham KANSAS

SEC.	TWP.	R.
36	8	25 W

WELL NO. # 1 ~~H. L. Bell~~ Schemberger FARM

COMPANY I. W. Seigle

CONTRACTOR Trans-Era


Wildcat

_____ Ft. from N. Line

_____ Ft. from S. Line

_____ Ft. from E. Line

_____ Ft. from W. Line

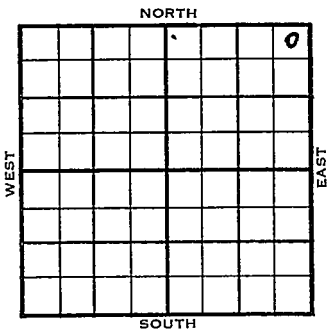

NE NE NE

Texas - DHM

1955 ELEVATION	REPORT
6/8	Location
8/14	Comm 6-11-55 Anh 2158 Tp ~~x3546~~ 3546 H 3733 3728 Tr 3756 3753 L 3769 3766 BKC 3996 3993 C Marm 4021 Miss 4342 4342 8 5/8" @ 217 w/140 DST 3792-3812 open 45 min. Rec 15' drlg mud. 1270/20" DST 3919-35 open 1 hr Rec 5' mud 5' oil 110/30" 5 1/2" @ 3975/125 CO to 3950 16/3924-30 500 A HFW reperf 3924-30 S/1 boph 500 A S/5 to 8 boph P/20 bo 24 hr. Comp 25 bopd 2 bw
	COMPLETED

DX-78

FORM 513 REV. SUNRAY

County Graham Elev.

Sec. 36 Twp. 8 Rge. 25W

Company I. W. Seigle

FarmName W. L. Bell No. 1


TOPS	DEPTH	LOG	DATUM
Anh.			
T.P.			
H.			
Tr.			
Dg.			
B.L.			
L.			
K.C.			
B.K.C.			
C.			
C.			
M.			
M.			
K.			
Mz.			
Mg.			
V.			
S.			
S.			
A			
R.			
P€.			
G.			
T.D.			

Loc. in Sec. NE NE NE

Geol.

Contr. Trans-Era

Pool Wildcat

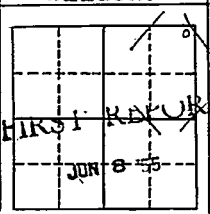

Date Comm. Texas - DHM

Location

Co. Lse. No. Sec. T. R.

FORM 513 REV. SUNRAY

County Graham Elev.

Sec. 36 Twp. 8 Rge. 25W

Company I. W. Seigle

Farm Name Schemberger No. 1


TOPS	DEPTH	LOG	DATUM
Anh.	2158		
Tp.		3546	1113
H.	3733	3728	1295
Tr.	3756	3753	1320
Dg.			
Bl.			
L.	3769	3766	1333
K.C.			
B.K.C.	3996	3993	1560
Ce.			
C. Marm		4021	1588
M. LS	4342	4342	1909
M.			
K.			
Mz.			
Mg.			
V.			
S.			
S.			
A			
R.			
Pe.			
G.			
T.D.	4353		

Loc. in Sec. NE NE NE

Geol.

Contr. Trans-Era

Pool W. Holly

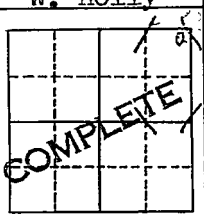

Date Comm. 6-11-55

SEP 14 1955

8 5/8" @ 217/140 DST 3792-3812 open 45 min. Rec. 15' drlg. mud 1270/20"

DST 3919-35 open 1 hr. Rec. 5' mud 5' oil 110/30" 5½" @ 3975/125

CO to 3950 16/ 3924-30 500 A

HFW reperf. 3924-30 S/ 1 b oph

500 A S/ 5 to 8 boph P/ 20 bo 24 hr.

Comp. 25 bopd 2 bw

Co. Lse. No. Sec. T. R.