

KANSAS

Graham

Section 36 Township 8 Range 22W

Well No. 1 DeDoer

Company J W Braden Drlg.

Wildcat

NORTH

				0			

WEST

EAST

SOUTH

KANSAS Graham

Sec. 36 Twp. 8 R. 22W ✓

Well No. #1 DeDoer Farm


J. W. Braden Drilling Company
Wildcat (Braden, Cont.)

330' Ft. from N. Line

_____ Ft. from S. Line

_____ Ft. from E. Line

330' Ft. from W. Line

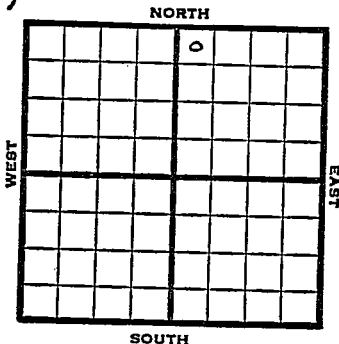

NW NE

1949 Elev 2147' REPORT

6/8 8" @ 317'
Drlg. 2015'
6/15 Lansing 3371'
Arb. 3724'
TD 3733'
5" @ 3725'
6/21 "
6/28 "
7/6 "
7/13 TD 3733'
Arb. 3724'
5" @ 3725'
Aband.

ABANDONED

Graham County Kansas State

Map No. Sec. 36 Twp. 8 R. 22W

Well No. 1 DeDoer

J. W. Braden Drlg. Company

Braden Contractor

NW NE

FIRST REPORT SECTION PLAT

330 Ft. from N. Line

Ft. from S. Line

Ft. from E. Line

330 Ft. from W. Line

Wildcat

Remarks:

8" @ 317 drlg. 2015

Date JUN 8 1949

Scout S. J. LEWIS

Kansas

Map No. _____ Sec. 36 Twp. 8 R. 22W

Well No. 1 DeDoer

J. W. Braden Drlg. Company

ABANDONED

Contractor

NW NE

E. 2147

SECTION PLAT

		0	

330 Ft. from N. Line

_____ Ft. from S. Line

_____ Ft. from E. Line

330 Ft. from W. Line

Graham County

Location _____

Rig up _____

Drilling and Remarks:

Cr 83724
5" 83725

RECORD

Cased _____ in., _____ ft.

Sand _____

Gas _____

Oil _____

Total Depth 3733

PRODUCTION

1st 24-hrs. Nat. _____

1st 24 hrs. after shot _____

Gas _____ Cu. Ft.

Dry Hole _____

Abandoned _____

Date

JUL 13 1949

19

S. J. LEWIS

Scout