

Rooks

DX 78-1

KANSAS

Section 36 Township 8 Range 19W

Well No. #1 Slanskey

Company Nadel & Gussman

NORTH

WEST

EAST

		0					

SOUTH

Rooks

KANSAS

SEC.

TWP.

R.

WELL NO.

36

8

19 W

COMPANY

1 Slanskey

FARM

CONTRACTOR

Nadel & Gussman

Reserve


330 Ft. from N. Line

Ft. from S. Line

990 Ft. from E. Line

Ft. from W. Line

NW NE SW

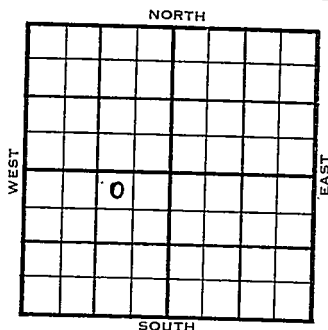

1954

ELEVATION

1997'

REPORT

9/1

Spud 8-24-54

8" @ 190

Dr1g. 2880'

9/8

Spud 8-24-54 D & A TD 3500

8" @ 190 Heeb 3181 Tor 3204


Lans 3220 Cong 3461 Ch. Cong 3470

TD 3500' D & A

ABANDONED

FABEN GILSTRAP

County _____ Rooks _____ State **Kansas**
 Sec. **36** (Blk.) **8** (Sur.) **19W** Map No. _____
 Operator **Nadel & Gussman**
 Well No. **1** Farm **Slanskey**
 Elev. **1997** Location **NW NE SW**

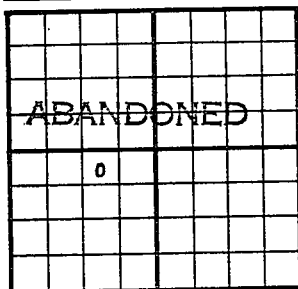

330 Ft. From **N** Line **SW**
990 Ft. From **E** Line **Quarter**

1st. Report _____

Completion **SEP 8 1954**

Remarks _____

Reserve - Contr.

Spudding Date **8-24-54**

Drilg. Data **D & A** **TD 3500**

8" @ 190 Heeb. 3181 Tor. 3204

Lans. 3220 Cong. 3461 Ch. Cong. 3470

TD 3500

D & A

FABEN GILSTRAP