


Sheridan

KANSAS

SECTION 36 TOWNSHIP 8 RANGE 27W

WELL NO. #1 Brown "D"

COMPANY Heathman & Seeligson

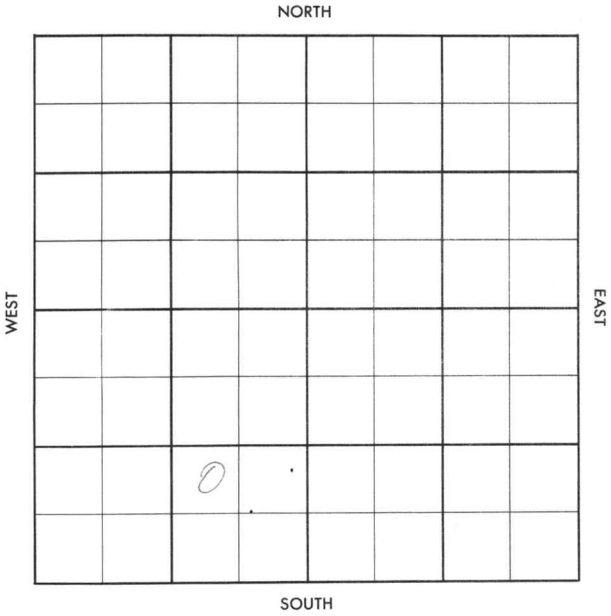

14

Sheridan

KANSAS

SEC.	TWP.	R.
36	8	27W

WELL NO.

#1 Brown "D"

FARM

COMPANY

Heathman & Seeligson

CONTRACTOR

Co.Tools


WILDCAT

_____ Ft. from N. Line

_____ Ft. from S. Line

_____ Ft. from E. Line

_____ Ft. from W. Line

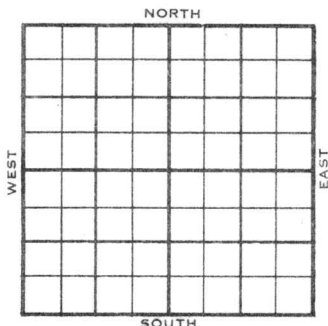

NW SE SW

Amerada BH Purchase

1956	ELEVATION	REPORT
	2660 KB	

5-23 Comm. 5-17-56
8" @ 294 w/175
Drlg. 3300'
Anh. 2271'

5-29 DST 3865-80 op 1 hr. rec. 10' mud,
1310
DST 3888-3912 op 30 min, rec. 1' mud,
BHP 0#
DST 3983-4010 op 30 min, rec. 4' mud,
1030/20"
D&A
Anh. 2271', L. 3830', BKC 4058'.
Log tops:
H. 3792', Tr. 3818', L. 3832',
BKC 4054'.
TD 4111'

ABANDONED

County Sheridan Elev. 2660 KB
 Sec. 36 Twp. 8 Rge. 27W
 Company Heathman & Seeligson
 Farm Name Brown "D" No. 1

TOPS	DEPTH	LOG	DATUM	Loc. in Sec.
Anh.	2271			NW SE SW
Tr.				
H.				
Tr.				
Dg.				
Bl.				
L.				Geol.
K.C.				Contr.
B.K.C.				Co. tools
Ce.				Pool
C.				Wildcat
M.				
M.				
K.				
Mz.				
Mq.				
V.				
S.				
S.				
A.				
R.				
Pe.				
G.				
T.D.				

FIRST REPORT	
MAY 23 1956	
0	

Date Comm. 5-17-56 Amerada BH Purchase
8" @ 294/175 drlg. 3300

313

County Sheridan Elev. 2660 KBSec. 36 Twp. 8 Rge. 27WCompany Heathman & SeeligsonFarm Name Brown "D" No. 1

TOPS	DEPTH	LOG	DATUM	Loc. in Sec.
Anh.	2271			NW SE SW
Tp.				
H.		3792		
Tr.		3818		
Dg.				
BL.				
L.	3830	3832	1172	Geol.
K.C.				Contr.
B.K.C.	4058	4054	1394	Co. tools
Ce.				Pool
C.				Wildcat
M.				
M.				
K.				
Mz.				
Me.				
V.				
S.				
S.				
A.				
R.				
Pe.				
G.				
TD.	4111			

ABANDONED

MAY 29 1956

Date Comm. 5-17-56 Amerada BH Purchase

8" @ 29L/175 drlg. 3300 MAY 29 '56

DST 3865 - 80 lhr see 10' Md
 1310/ DST 3888-3912 30"
 see 1' Md BHPD DST 3983
 - 4010 30" see 4' Md 1020/20"

D & A