

Thomas


KANSAS

FORM 51 IOM 12-46 PETROL

Section 36 Township 8 Range 31W

Well No. 1 Meeks

Company Texas

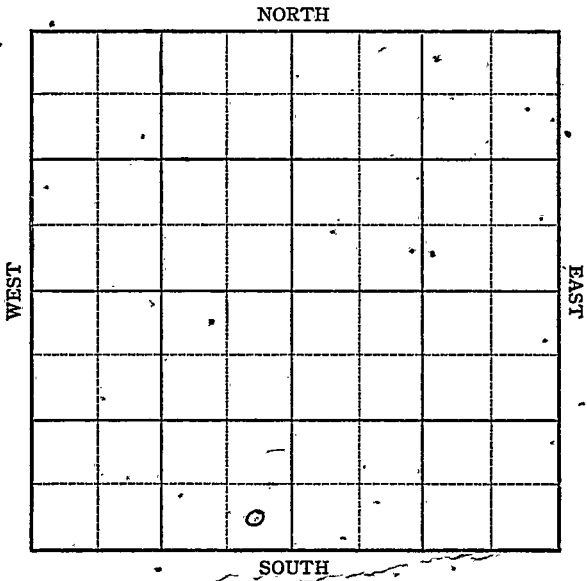

14

KANSAS

Thomas county

Sec. 36 Twp. 8 R. 31W

Well No. 1 Meeks Farm
Texas Company

Wildcat

Ft. from N. Line


330

Ft. from S. Line

330

Ft. from E. Line

Ft. from W. Line

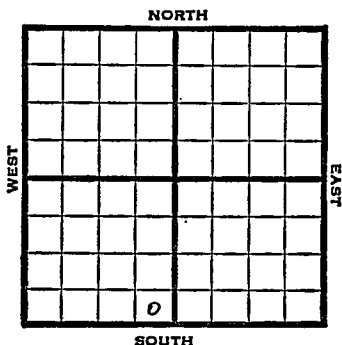

SE SW

1947 Elev. 2984' REPORT

- 5/28 RUR
- 6/3 13" @ 396'
Drlg 1824'
- 6/10 Dakota 1490
FtKiley 8006
Drlg. 3370'
- 6/21 " "
- 6/24 Cong. 4601
Mississippi 4480'
Drlg 4816'
- 7/2 Arb. 4852'
TD 4942'

ABANDONED

Map No. _____ Sec. 36 Twp. 8 R. 31W

Well No. 1 Meeks

Texas Company

FIRST REPORT Contractor

SE SW

SECTION PLAT

_____ Ft. from N. Line

330 Ft. from S. Line

330 Ft. from E. Line

_____ Ft. from W. Line

| | | | |
|--|--|--|--|
| | | | |
| | | | |
| | | | |
| | | | |

Thomas County

Location _____

Rig up _____

Drilling and Remarks:

R U R

RECORD

Cased _____ in., _____ ft.

Sand _____

Gas _____

Oil _____

Total Depth _____

PRODUCTION

1st 24 hrs. Nat. _____

1st 24 hrs. after shot _____

Gas _____ Cu. Ft.

Dry Hole _____

Abandoned _____

Date

MAY 28 1947 19

S. J. LEWIS Scout

Map No. 0 Sec. 36 Twp. 8 R. 31W

Well No. 1 Meeks

Texas

Company

ABANDONED

Contractor

SE SW

E1,2984
SECTION PLAT

_____ Ft. from N. Line

330 Ft. from S. Line

330 Ft. from E. Line

_____ Ft. from W. Line

| | | | |
|--|--|--|--|
| | | | |
| | | | |
| | | | |
| | | | |

Thomas County

Location _____

Rig up _____

Drilling and Remarks:

Per 4802

RECORD

Cased _____ in., _____ ft.

Sand _____

Gas _____

Oil _____

Total Depth 4942

PRODUCTION

1st 24 hrs. Nat. _____

1st 24 hrs. after shot _____

Gas _____ Cu. Ft.

Dry Hole _____

Abandoned _____

Date

JUL 2 1947

S. J. LEWIS Scout