

Section 4 Township 8 Range 17W

Well No. #1 Dancer

Company Murfin Drlg.

NORTH

			6				

WEST

EAST

SOUTH

Rooks

KANSAS

Sec. 4 Twp. 8 R. 17W

Well No. #1 Dancer Farm

Murfin Drlg. Company

Murfin Contractor

Wildcat


330 Ft. from N. Line

\_\_\_\_\_ Ft. from S. Line

330 Ft. from E. Line

\_\_\_\_\_ Ft. from W. Line

NE NE NW

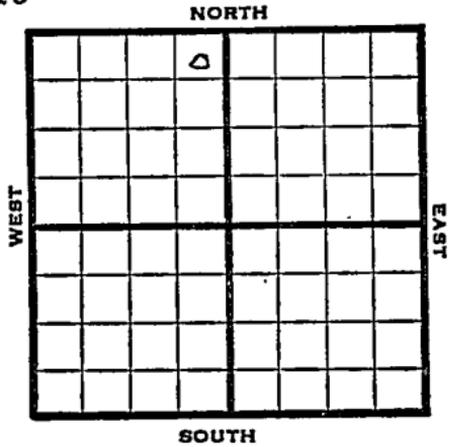

1952 Elev. 1881' REPORT

- 2/13 Spud 2-9-52  
8" @ 130'  
Anhy 1273'  
Drlg. 1750'
- 2/20 Topeka 2799' Heeb 3011' Tor 3036'  
Lans. 3055'  
DST 3057-3108, 1 hr, 8' M 300#  
DST 3143-58 1/2 hr, 60' SOCM, 270'  
HO & GCM, 30' wtr. 1150#  
Arb. 3349' TD 3355' 5" @ 3350
- 3/5 TD 3387' PB 3180'  
21/3142-46 1000 A S/26 1/2 BO plus  
trace wtr 1 hr. S/7 1/2 BO in 15 mins  
Fill up 2300' oil plus 13 gal wtr.  
12 hrs. POP
- 3/12 S/25 BOPH 1 hr. POP
- 3/19 "

OVER

1952

4/2 Spud 2-9-52  
Oil Well TD 3387  
8" @ 130 Anhy 1273  
Top 2799 Heeb. 3011  
Tor. 3036 Lans. 3055  
DST 3057-3108 opn 1 hr. Rec. 8' mud  
DST 3143-58 opn  $\frac{1}{2}$  hr. Rec. 60' socm  
270' ho & gcm 30' wtr Arb. 3349  
TD 3355 5" @ 3350 DD 3364  
DD 3387 Shut down 14 hr. Rec. wtr  
PB 3180 21/3142-46 1000 A  
S/26 $\frac{1}{2}$  bo 1 hr. S/7 $\frac{1}{2}$  bo 15 min.  
FU 2300' oil 13 gw 12 hrs.  
S/25 boph Comp. 227 bopd 32% wtr.

**COMPLETED**



County \_\_\_\_\_ Rocks \_\_\_\_\_ State Kansas

Sec. 4 (Blk. Twp.) 8 (Sur. Rge.) 17W Map No. \_\_\_\_\_

Operator Murfin Drlg.

Well No. 1 Farm Dancer

Elev. 1881 Location NE NE NW


330 Ft. From N Line NW

330 Ft. From E Line Quarter

1st. Report \_\_\_\_\_

Completion APR 2 1952

Remarks Wildcat

Murfin Drlg. - Contr.

Spudding Date 2-9-52

Drlg. Data Oil well TD 3387

8" @ 130 Anhy 1273 Top. 2799

Heeb. 3011 Tor. 3036 Lans. 3055

DST 3057-3108 open 1 hr. Rec. 8' mud

DST 3143-58 open 1/2 hr. Rec. 60' socm

270' ho & gcm 30' water Arb. 3349

TD 3355 5" @ 3350 DD 3364 DD 3387

Shut down 14 hr. Rec. water PB 3180

21/ 3142-46 1000 A S/ 26 1/2 bo 1 hr.

S/ 7 1/2 bo 15 min. FU 2300' oil 13 gw 12hr

S/ 25 boph Comp. 227 bopd 32% water

J. G. McGEHEE