



Sec. 4 Twp. 8 R. 17W

Well No. #2 Hunter Farm

Bay Petr. Company

Contractor


Ft. from N. Line

330' Ft. from S. Line

990' Ft. from E. Line

Ft. from W. Line

SW SE SW

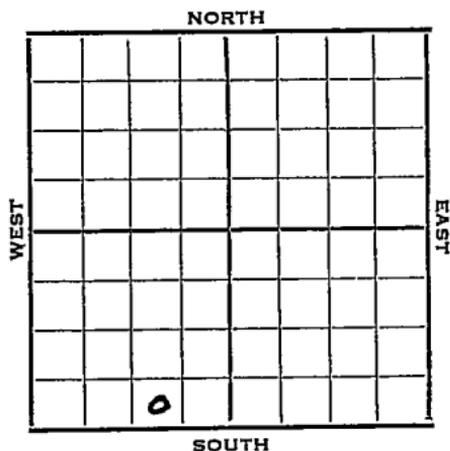

1952

Elev. 1938'

REPORT

9/17

Location

9/24

8" @ 195 Anhy 1300'
Drlg. 1547'

10/1

Topeka 2867
DST 3013-43 1 hr., 240' SW
1230# Heeb 3070 Lans 3112
DST 3191-3223 1 hr., 135' SW
1110#
Drlg. 3230

10/8

Spud 9-18-52
D&A TD 3457
8" @ 195'
Anhy 1300 Top. 2867
DST 3013-43 open 1 hr. rec. 240' SW
1230#
Heeb. 3070 Lans. 3112
DST 3191-3223 open 1 hr. rec. 135'
SW 1110#
DST 3286-3344 open 1 hr. rec. 135' SW
1110# Cong. 3374 Ch Cong. 3417
TD 3457 D&A

ABANDONED

