


Section 4 "Township 8 Range 17W

Well No. #3 Hunter

Company Bay Pet.

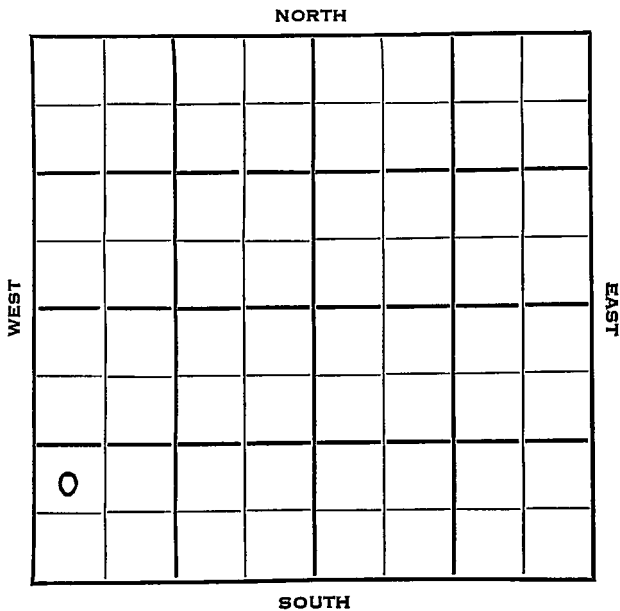

Rooks
8

KANSAS

17W

Sec. 4 Twp. _____ R. _____

#3 Hunter

Well No. _____ Farm _____

Bay Petr.

Company _____

Contractor _____

Lone Star Pool


_____ Ft. from N. Line

990 _____ Ft. from S. Line

_____ Ft. from E. Line

330 _____ Ft. from W. Line

NW SW SW

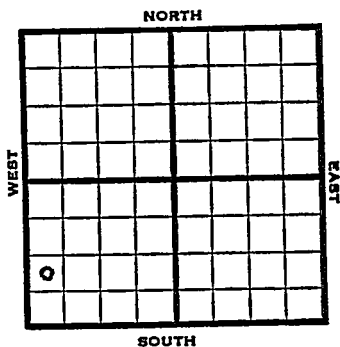

1953

Elev. 1953' REPORT

4/22

Location

4/30

Top 2869, Heeb 3067, Tor 3090, Lans 3110

DST 3149-88, 1/2 hrs., 15' M

DST 3190-3216, 1 hr., 300' hly O&GCM, 660' O&GCM, 240' wtr., 1100#

DST 3261-3303

5/7

DST 3261-3303', 1/2 hr, 10' SOCM

Arb. 3402' RTD 3406 5" @ 3403

5/21

CO 3406 DD 3417' TD 10 GOPH 500 A

S/7 BOPH POP

5/27

Spud 4-17-53

Oil Well

TD 3417'

8" @ 197'

Top 2869, Heeb 3067, Tor 3090, Lans 3110

DST 3149-88 opn 1/2 hr, rec 15' mud O#

DST 3190-3216 opn 1 hr, rec 300' ho &

gcm 660' o & gcm, 240' wtr. 1100#

DST 3261-3303 opn 1/2 hr, rec 10' socm

O# Arb 3402

TD 3406'

5" @ 3403'

CO to 3406 DD 3417 10 goph 500A

S/ 7 boph Comp. 107 bopd 2% wtr.

COMPLETED

