


Section 4 Township 8 Range 26 W

Well No. # 1 Gulick

Company Virginia Drlg.

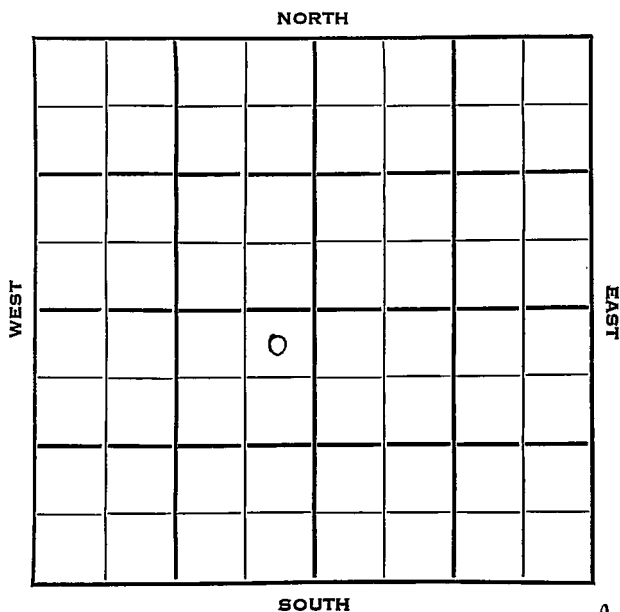

11

Sheridan KANSAS

SEC.	TWP.	R.
4	8	26 W ✓

WELL NO. # 1 Gulick FARM

COMPANY Virginia Drlg.

CONTRACTOR

Wildcat


330 Ft. from N. Line

Ft. from S. Line

330 Ft. from E. Line

Ft. from W. Line

NE NE SW

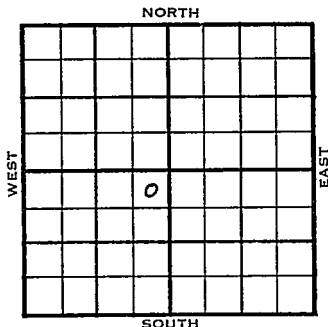

Phillips - DHM

1954	ELEVATION 2565'	REPORT
------	-----------------	--------

2/3 MIM
 2/10 8" @ 256' w/165 sks
 Anhy 2200'
 Drlg. 3520'
 2/17 Spud 2-3-54
 D & A
 TD 4613'
 8" @ 256'
 Anhy 2200', Heeb 3736', Tor 3763',
 Lans 3778', B KC 4003', Miss 4364',
 Viola 4494', Arb 4551'
 TD 4613'
 D & A

ABANDONED

