


Section 4 Township 8 Range 24 W

Well No. # 1 Goff

Company E. K. Carey

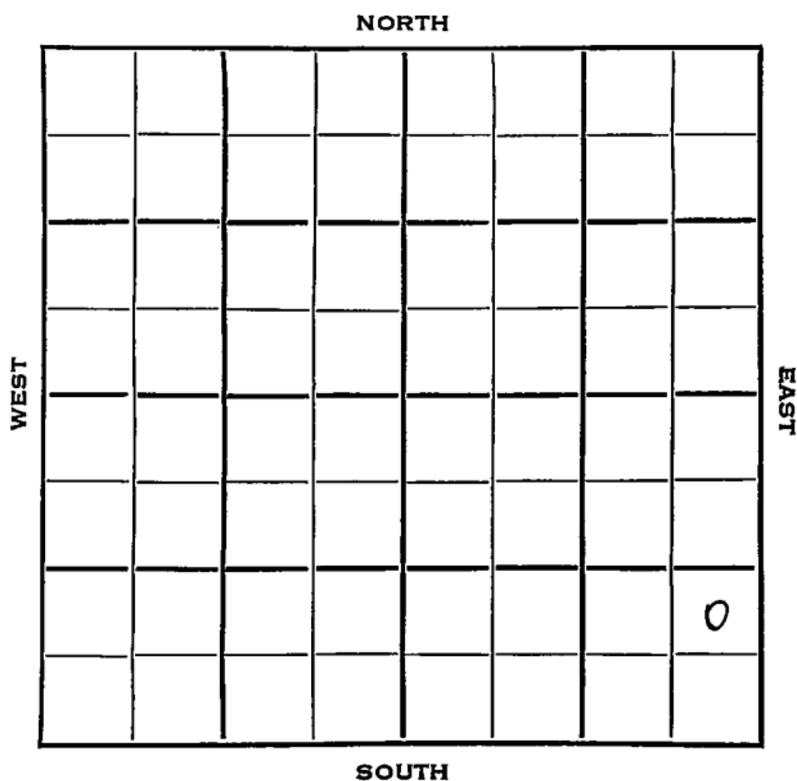

16





