


Graham KANSAS

Section 4 Township 8 Range 24 W

Well No. # 1 Neal

Company Derby Oil

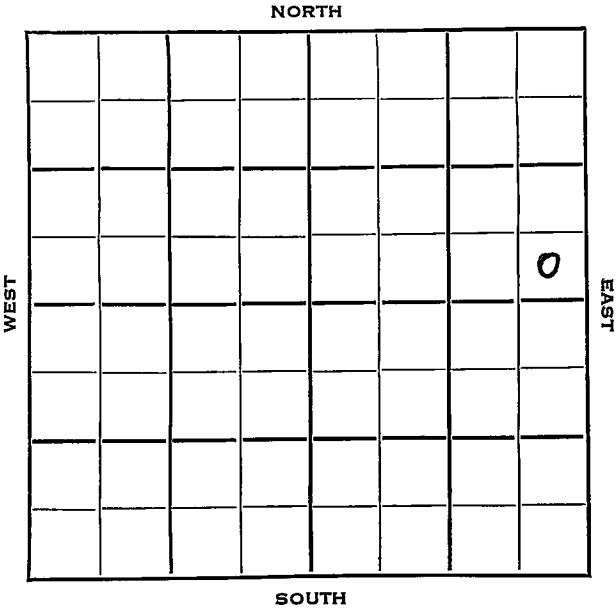

8

Graham

SEC.	TWP.	R.	KANSAS
4	8		24W ✓

WELL NO.

#1 Neal

FARM

COMPANY

Derby Oil

CONTRACTOR

Carl Todd


_____ Ft. from N. Line

330 _____ Ft. from S. Line

330 _____ Ft. from E. Line

_____ Ft. from W. Line

SE SE NE

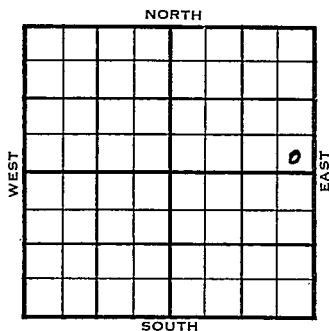

1953

ELEVATION

2339'

REPORT

11/18

Location


1954
1/20

Spud 11-27-53 Oil well TD 3825
 8" @ 130 Heeb 3549 Lans 3567
 DST 3642-72 open $\frac{1}{2}$ hr rec 515'
 SGCSW 1425#
 DST 3746-56 open 1 hr rec 2600' free
 oil 1600#
 DST 3766-72 open 1 hr rec 1230'
 gassy oil, 1400# B KC 3804
 TD 3825 5" @ 3824 CO to 3791
 31/3753-58 S/131 BO 6 hr. FU 3200'
 oil 500 A S/109 BO 3 hr. HFO
 Comp. 2434 BOPD

COMPLETED

J. G. McGEHEE

County Graham State Kansas
 Sec. 4 (Blk.) 8 (Sur. Rge.) 24W Map No. _____
 Operator Derby Oil
 Well No. 1 Farm Neal
 Elev. 2339 Location SE SE NE

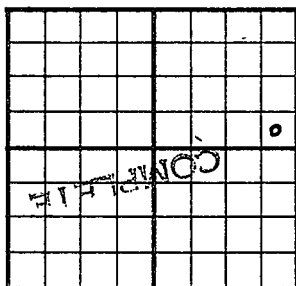

330 Ft. From S Line NE
330 Ft. From E Line Quarter
 1st. Report _____
 Completion JAN 20 1954
 Remarks _____
Carl Todd - Contr.
 Spudding Date 11-27-53

Drilg. Data Oil well TD 3825
8" @ 130 Heeb. 3549 Lans. 3567
DST 3642-72 open $\frac{1}{2}$ hr. Rec. 515' sgs
1425# DST 3746-56 open 1 hr. Rec. _____
2600' free oil 1600# DST 3766-72
open 1 hr. Rec. 1230' gassy oil 1400#
B KC 3804 TD 3825 5" @ 3824 CO to 3791
31/ 3753-58 S/ 131 bo 6 hr. FU 3200'
oil 500 A S/ 109 bo 3 hr. HFO _____
 Comp. 2434 bopd