


Section 4 Township 8 Range 22 W

Well No. # 1 Harrison

Company Murfin & Sitrin

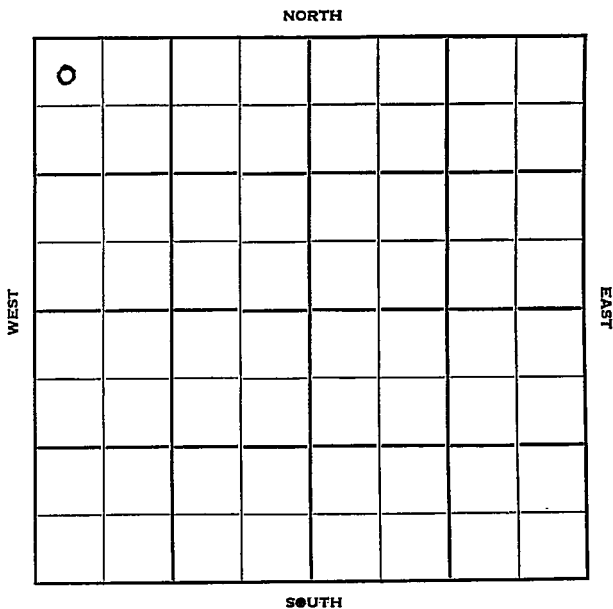

Graham

Sec. 4 Twp. 8 R. 22W

Well No. #1 Harrison Farm

Murfin & Sitrin Company

Murfin - Contr. Contractor


330' Ft. from N. Line

Ft. from S. Line

Ft. from E. Line

330' Ft. from W. Line

NW NW NW

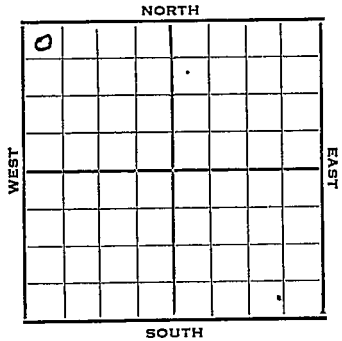

1952 Elev. 2174' REPORT

2/27 Spud 2-22-52
10" @ 164
Anhy 1800
Drlg. 2147'

3/5 Drlg. 3705'

3/12 Heeb 3374' Lans. 3411'
DST 3437-57, 1 1/2 hrs, 45' OCM. 1200#
DST 3470-90', 1 hr, 180' oil, 135'
muddy oil. 1125#
Arb. 3742' RTD 3751' 5" @ 3743'

3/19 "

3/25 MICT

4/1 "

4/9 DD to 3756 fill up 200' oil
36 hrs. 1000 A No help. PB to ?
24/ 3592-98 S/ 20 BOPH POP

4/23 NR

4/30 "

5/7 "

5/14 "

5/21 Spud 2-22-52
Oil Well TD 3756' 10" @ 164'
Anhy 1800 Heeb. 3374
Lans. 3411
DST 3437-51 open 1 1/2 hr. rec. 45' socm
DST 3470-90 open 1 hr. rec. 180' oil
135' muddy oil

OVER

1952

5/21 Arb. 3742 TD 3751 5" @ 3743
DD 3756 FU 200' oil 36 hr.
1000 A no inc. PB 24/ 3592-98
S/ 20 boph Comp. 428 bopd

COMPLETED

County **Graham** State **Kansas**

Sec. **4** (Blk. Twp.) **8** (Sur. Rge.) **22W** Map No.

Operator **Murfin & Sitrin**

Well No. **1** Farm **Harrison**

Elev. Location **NW NW NW**

0							

FIRST REPORT

330 Ft. From **N** Line **NW**

330 Ft. From **W** Line Quarter

Ist. Report **FEB 27 1952**

Completion

Remarks

Murfin - Contr.

Spudding Date **2-22-52**

Drlg. Data **10" @ 164 Any 1800 Drlg. 2147**

J. G. McGEHEE

County Graham State Kansas

Sec. 4 (Blk. 8 (Sur. 22W Map No. 8)
(Twp. 8 (Rge. 22W))

Operator Murfin & Sitrin

Well No. 1 Farm Harrison

Elev. 2174 Location NW NWNW

0					

COMPLETE

330 Ft. From N Line NW

330 Ft. From W Line Quarter

1st. Report

Completion MAY 21 1952

Remarks

Murfin Drlg. - Contr.

Spudding Date 2-22-52

Drlg. Data Oil well TD 3756

10" @ 164 Anhy 1800 Heeb. 3374

Lans. 3411 DST 3437-51 open 1 1/2 hr.

Rec. 45' soom DST 3470-90 open 1 hr.

Rec. 180' oil 135' muddy oil

Arb. 3742 TD 3751 5" @ 3743

DD 3756 FU 200' oil 36 hr. 1000 A

no inc. PB 24/ 3592-98 S/ 20 boph

Comp. 428 bopd

J. G. McCall