


Section 5 Township X 8 Range 17N

Well No. #3 Eckert

Company V. D. Sidey

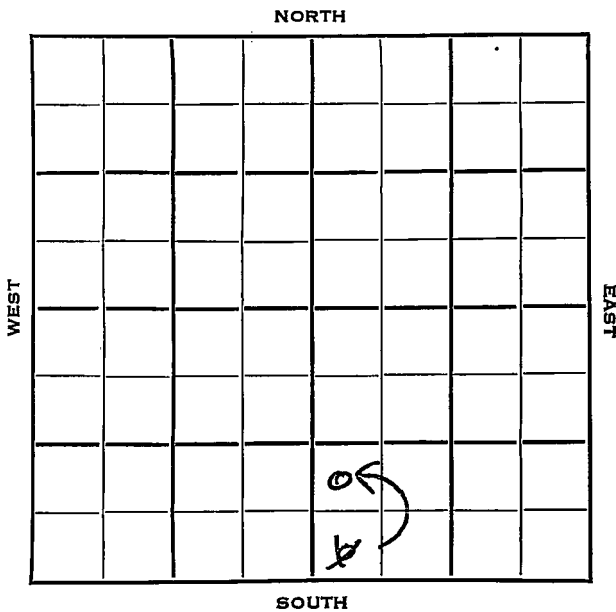



Sec. 5 Twp. 8 R. 17 W

Well No. # 3 Eckert Farm

V. D. Sidey Company

Sidey Contractor

Ft. from N. Line

990

Ft. from S. Line


~~330~~

Ft. from E. Line

330

Ft. from W. Line

~~SW SW SE~~
NW SW SE

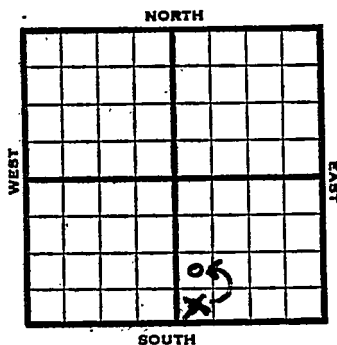

1953

Elev. 1854' REPORT

2/18

Spud 2-15-53

8" @ 98

Drlg.

2/26

Tite hole

3/12

Arb. 3313' RTD 3323 5" @ 3315

3/19

CO 3323' 1000 A

3/26

NR

4/2

"

4/9

"

4/16

"

4/23

"

4/30

"

5/7

"

5/21

"

5/28

"

6/3

"

6/24

NR

7/1

Spud 2-15-53 SWD well TD 3600

8" @ 98 Anhy 1208 - Top 2784

Heeb 2990 Lans 3026 Arb. 3315

TD 3600

Comp. for SWD well

ABANDONED

County _____ Rocks _____ State Kansas

Sec. 5 (Blk. Twp.) 8 (Sur. Rge.) 17W Map No. _____

Operator V. D. Sidey

Well No. 3 Farm Eckert

Elev. 1854 Location NW SW SE

ABANDONED

990 Ft. From S Line SE

330 Ft. From W Line Quarter

Ist. Report _____

Completion JUL 1 1953

Remarks _____

Sidey - Contr.

Spudding Date 2-15-53

Drlg. Data SWD well TD 3600

8" @ 98 Anhy 1208 Top. 2784

Heeb. 2990 Lans. 3026 Arb. 3315

TD 3600 Comp. for SWD well

411925

Map No. _____ Sec. 5 Twp. 8 R. 17W

Well No. 3 Eckert

V. D. Sidey Company

CORRECTION Contractor

NW SW SE

SECTION PLAT

_____ Ft. from N. Line

990 Ft. from S. Line

_____ Ft. from E. Line

330 Ft. from W. Line

		o	

Rooks County

Location _____

Rig up _____

Drilling and Remarks:

Reported

SW SW SE

RECORD

Cased _____ in., _____ ft.

Sand _____

Gas _____

Oil _____

Total Depth _____

PRODUCTION

1st 24 hrs. Nat. _____

1st 24 hrs. after shot _____

Gas _____ Cu. Ft.

Dry Hole _____

Abandoned _____

Date

FEB 25 1953

19

J. G. McGEHEE

Scout