


Rooks,

KANSAS

SECTION 5 TOWNSHIP 8 RANGE 17W

WELL NO. #3 Forrest

COMPANY V. D. Sidey

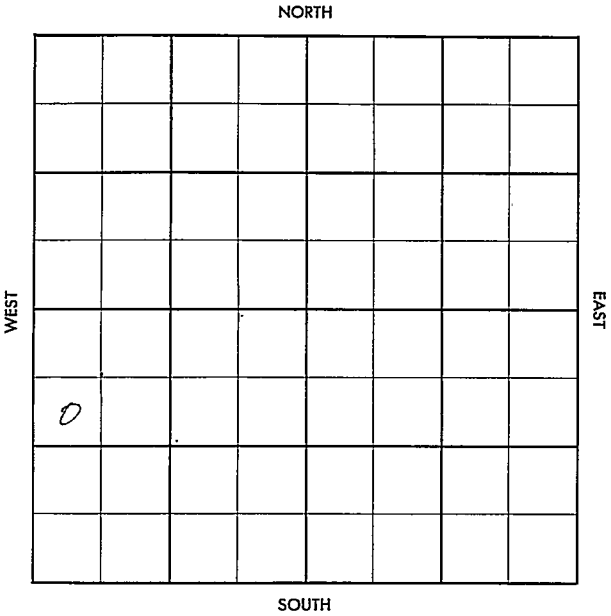

Rooks

KANSAS

SEC.

TWP.

R.

5

8

17W

WELL NO.

#3 Forrest

COMPANY

FARM

V.D. Sidey

CONTRACTOR

Co. Tools


Lone Star

Ft. from N. Line

Ft. from S. Line

Ft. from E. Line

Ft. from W. Line

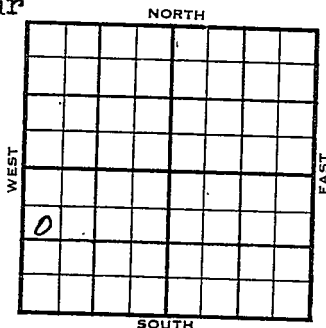

SW NW SW

1956

ELEVATION

1902'

REPORT

5-9

Comm. 5-7-56

7-11

8 5/8" @ 190

5 1/2" @ 3254 w/125

CO 3365

P 25 bopd

L. 3069', A. 3363',

TD 3365'

~~ABANDONED~~

COMPLETED

County Rocks Elev. _____
 Sec. 5 Twp. 8 Rge. 17W
 Company V. H. Sidey
 FarmName Forrest No. 3

TOPS	DEPTH	LOG	DATUM	Loc. in Sec.
Anh.				SW NW SW
Tr.				
H.				
Tr.				
Dg.				
Bl.				
L.				
K.C.				Geol. _____
B.K.C.				Contr. _____
Ce.				Co. tools
C.				
M.				Pool
M.				Lone Star
K.				
Mz.				
Me.				
V.				
S.				
S.				
A.				
R.				
Pe.				
G.				
TD.				

Date Comm. 5-7-56

FIRST REPORT			
0	MAY	9	56

6661 1 1 74.61

0.5

County Rocks Elev. 1900
 Sec. 5 Twp. 8 Rgs. 17W
 Company V. D. Sidey
 Farm Name Forrest No. 3

TOPS	DEPTH	LOG	DATUM	Loc. in Sec.
Anh.				SW NW SW
Tp.				
H.				
Tr.				
Dg.				
Bl.				
L.	3069			Geol.
K.C.				Contr.
B.K.C.				Co. tools
Ce.				Pool
C.				Lone Star
M.				
M.				
K.				
Mz.				
Mo.				
V.				
S.				
S.				
A.	3353			COMPLETE
R.				
Pe.				
G.				
T.D.	3365			JUL 1 1 1956

Date Comm. 5-7-56 MAY 15 '56 85/8 190

1 2990 MAY 23 '56 Pipe set MAY 27 '56

5 1/2 3254 / 125 JUN 1 '56 JUN 1 '56

JUN 20 '56 JUN 27 '56 JUL 1 '56 JUL 1 '56 CO 3365

in Pop. P. 25 Bopd.