


Section 5 Township 8S Range 17W

Well No. #2 Frank

Company V. D. Sidey Oil Co

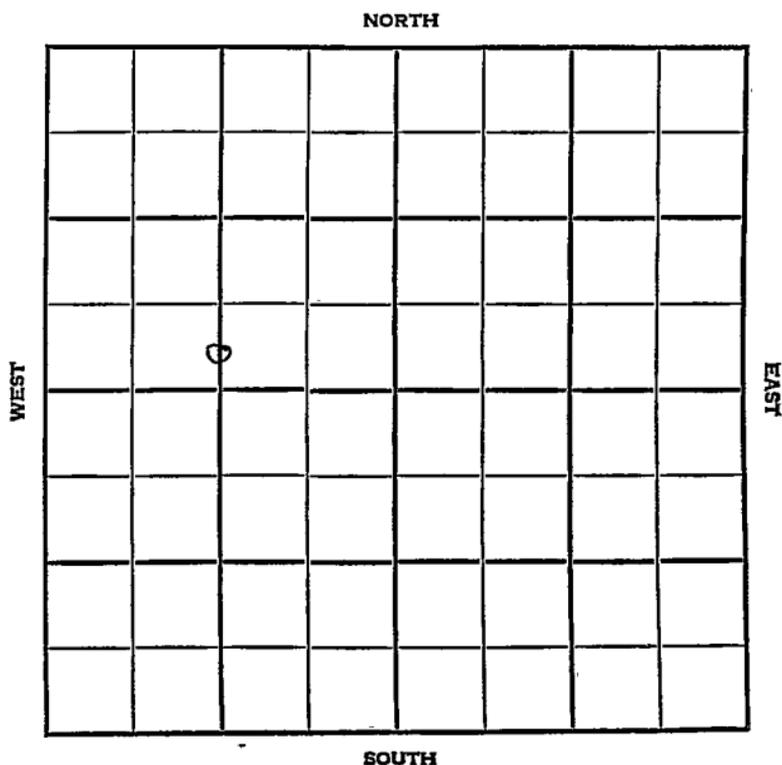

Rooks

KANSAS

SEC.

TWP.

R.

5

8

17W

WELL NO.

#2 Frank

COMPANY

FARM

V.D. Sidey Oil Co.

CONTRACTOR

Co.

Lone Star


NORTH

_____ FT. FROM N. LINE

_____ FT. FROM S. LINE

_____ FT. FROM E. LINE

_____ FT. FROM W. LINE

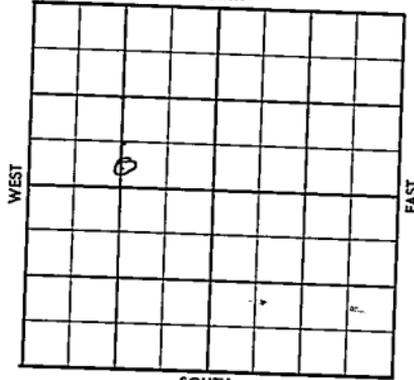

C S $\frac{1}{2}$ S $\frac{1}{2}$ NW $\frac{1}{4}$

ELEVATION

1956

REPORT

8-29 MIRT

County Rooks Elev. _____
 Sec. 5 Twp. 8S Rgs. 17W
 Company V. D. Sidey Oil Co.
 FarmName Frank No. 2

Co.

TOPS	DEPTH	LOG	DATUM
Anh.			
Tp.			
H.			
Tr.			
Dg.			
Bl.			
L.			
K.C.			
B.K.C.			
Ce.			
C.			
M.			
M.			
K.			
Mz.			
Ma.			
V.			
S.			
S.			
A.			
R.			
PE.			
G.			
T.B.			

Loc. in Sec. C S $\frac{1}{2}$ S $\frac{1}{2}$ NW $\frac{1}{4}$
 Geol. _____
 Contr. _____
 Co. _____
 Pool Lone Star
 FIRST REPORT
 AUG 29 '56

Lse.

No.

Sec.

T.

R.

Date Comm. _____

MIRT

SEP 2 1956



Cd.

County Books Elev. 1829
 Sec. 5 Twp. 8S Rge. 17W
 Company V. D. Sidey Oil Co.
 FarmName Frank No. 2

TOPS	DEPTH	LOG	DATUM
Ans.			
Tr.			
H.			
Tr.			
Dg.			
Bl.			
L.	<u>2994</u>		
K.C.			
B.K.C.			
Ce.			
C.			
M.			
M.			
K.			
Mz.			
Mo.			
V.			
S.			
S.			
A.	<u>3278</u>		
R.			
PE.			
G.			
TD.	<u>3280</u>		

Loc. in Sec. G S $\frac{1}{2}$ S $\frac{1}{2}$ NW $\frac{1}{4}$
 Geol. _____
 Contr. _____
 Co. _____
 Pool Lone
Star

SEP 19 '56	
COMPLETE	

Loc.

No.

Sec.

T.

R.

Date Comm. SEP 5 '56
MIRT X spd 8-28-56 8 5/8
@ 103 / 100 @ 2640 SEP 12 '56 5 1/2
@ 3279 SEP 19 '56 DD 3281 \$ 3 Bopd
now for est P. 25 Bopd
not cstr.