


Rooks

Section 5 Township 8 Range 17 W

Well No. # 1 Stamper "B"

Company Murfin Drlg.

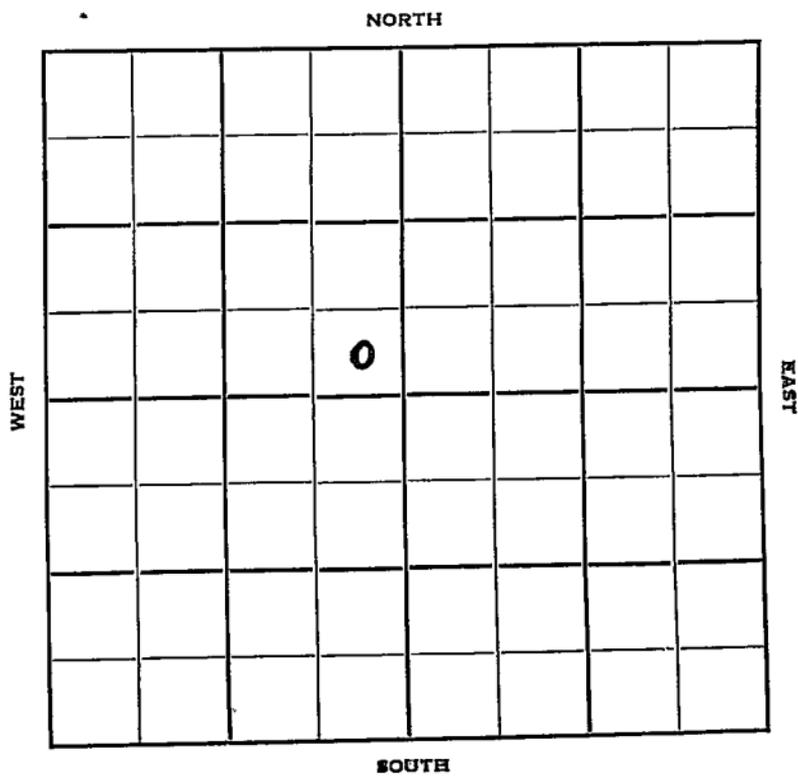

Rooks

Sec. 5 Twp. 8 R. 17W

Well No. #1 Stamper "B" Farm

Murfin Drlg. Company

Contractor


Ft. from N. Line

330 Ft. from S. Line

330 Ft. from E. Line

Ft. from W. Line

SE SE NW
Stanolind farmout

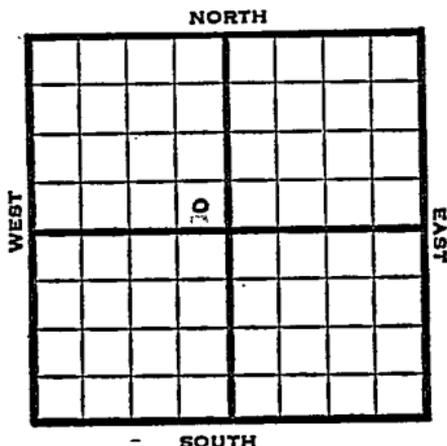

1952 Elev. 1824' **REPORT**

10/1 Location

- 10/8 8" @ 131
Anhy 1229
Drlg. 1871'
- 10/15 Topeka 2738, Heeb 2951, Toronto 2974,
Lans 2993
DST 3080-3100, 1 hr., 90' HOCM
Drlg. 3140'
- 10/22 Arb 3287'
RTD 3289'
5" @ 3288'
- 10/29 No report
- 11/5 NR
- 11/12 "
- 11/20 NR
- 11/27 NR
- 12/4 NR
- 12/10 Spud 10-2-52
Oil well TD 3295' 8" @ 131
Anhy 1229' Top. 2738' Heeb 2951'
Tor. 2974' Lans. 2993'
DST 3080-3100, open 1 hr. rec 90' HOCM

OVER

1952

12/10 (Information continued)

Arb. 3287' TD 3289' 5" @ 3288

DD 3295' 3' GOPH 1000 A

FU 2000' oil 16 hr. S/12 BOPH

Comp. 265 BOPD

COMPLETED

