


Section 5 Township 8 **KANSAS** Range 17W

Well No. #1 Stamper "D"

Company Murfin Drlg.

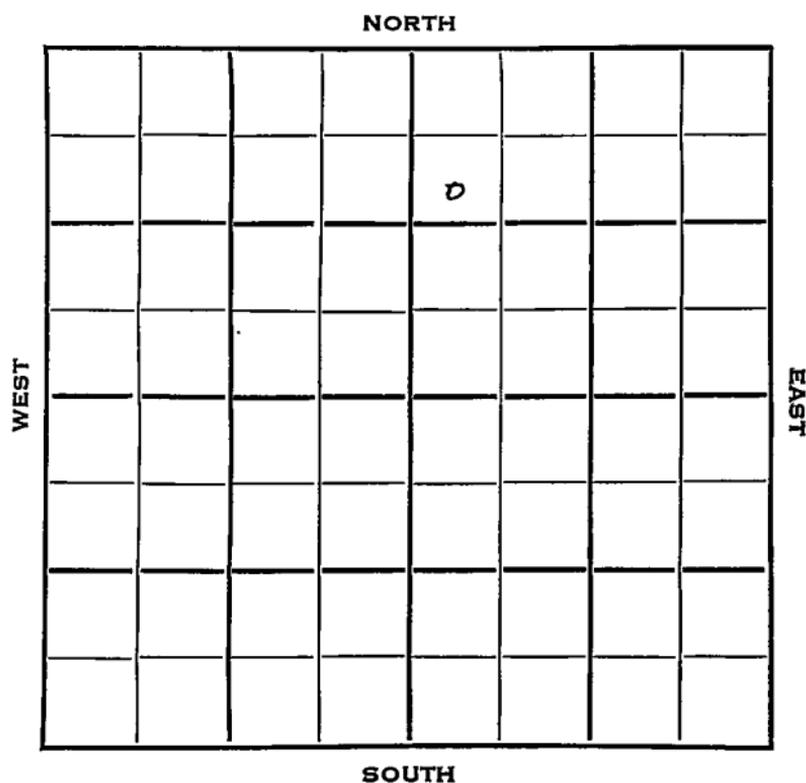

Sec. 5 Twp. 8 R. 17 W

Well No. #1 Stamper "D" Farm _____

Murfin Drlg. Company _____

Lone Star Pool Contractor _____


990 Ft. from N. Line

_____ Ft. from S. Line

_____ Ft. from E. Line

330 Ft. from W. Line

SW NW NE

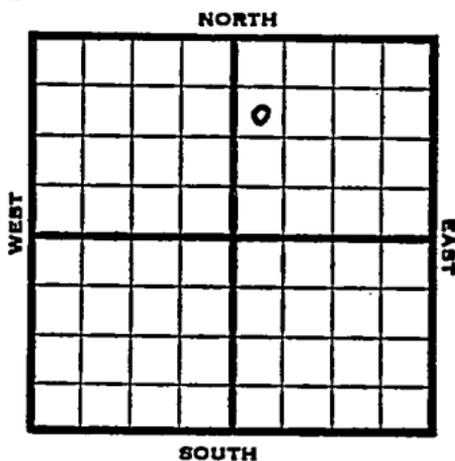

1953 Elev. 1870' REPORT

- 1/28 Location
- 2/5 8" @ 122
- 2/12 Anhy 1273'
Drlg. 3012'
- 2/19 Top 2794' Heeb 3007' Tor 3033'
Lans 3050' Arb. 3344'
RTD 3348' 5" @ 3345' CO
- 2/26 DD 3354' 1000 A DD
- 3/13 NR
- 3/19 "
- 3/26 "
- 4/2 "
- 4/9 "
- 4/16 "
- 4/23 "
- 4/30 "
- 5/7 NR
- 5/21 "
- 5/27 Spud 2-2-53
D & A
TD 3354'
8" @ 122'
Anhy 1273, Top 2794, Heeb 3307, Tor 3033, Lans 3050, Arb 3344

OVER

1953

Information brought forward.

5/27 TD 3348'
5" @ 3345'
DD 3354 1000 A
D & A

ABANDONED

County Rooks State Kansas

Sec. 5 (Blk. 8 (Sur. 17W (Twp.) (Rge.) Map No.

Operator Murfin Drig.

Well No. 1 Farm Stamper "D"

Elev. Location SW NW NE

		o		
FIRST REPORT				

990 Ft. From N Line NE

530 Ft. From W Line Quarter

1st. Report JAN 28 1953

Completion

Remarks

Spudding Date

Drig. Data Lone Star Pool

Location

