


Section 5 Township 8 Range 14NWell No. #1 DeanCompany Westgate-Greenland et al

Wildcat

NORTH

WEST

EAST

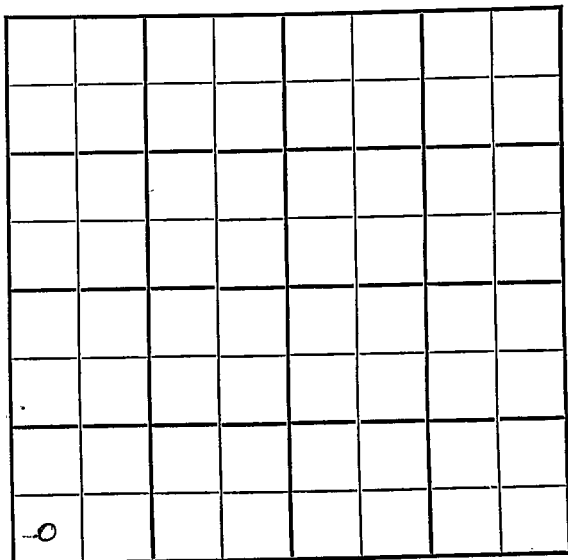

SOUTH

Osborne

Sec. 5 **KANSAS** Twp. 8 R. 14W

Well No. #1 Dean Farm

Westgate-Greenland et al Company

Wildcat


Ft. from N. Line

330' Ft. from S. Line

Ft. from E. Line

330' Ft. from W. Line

SW/C

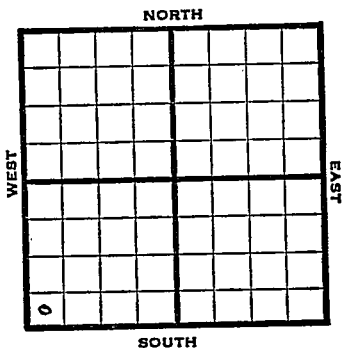

1948

Elev. 1808' REPORT

2/11

Location

2/18

"

2/25

8" @ 140'
Drlg. 2940'

3/3

Heeb. 2881'
Lans. 3038'
Viola 3551'
Simp 3670'
Arb. 3725'
Total Depth 3764'

ABANDONED

Map No. _____ Sec. 5 Twp. 8 R. 14W

Well No. 1 Dean


Westgate-Greenland et al. Company

FIRST REPORT

Contractor

SW/C

SECTION PLAT

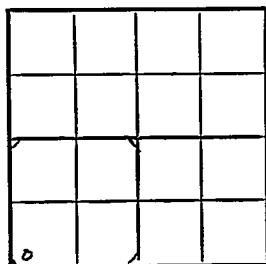

_____ Ft. from N. Line

330 Ft. from S. Line

_____ Ft. from E. Line

330 Ft. from W. Line

Osborne County

Location X

Rig up _____

Drilling and Remarks:

RECORD

Cased _____ in., _____ ft.

Sand _____

Gas _____

Oil _____

Total Depth _____

PRODUCTION

1st 24 hrs. Nat. _____

1st 24 hrs. after shot _____

Gas _____ Cu. Ft.

Dry Hole _____

Abandoned _____

Date

FEB 1 1 1948

19

S. J. LEWIS

Scout

Map No. 63 Sec. 5 Twp. 8 R. 14W

Well No. 1 Dean

Westgate-Greenland etal. Company

ABANDONED

Contractor

SW/C


E 11808
SECTION PLAT

 Ft. from N. Line

330 Ft. from S. Line

 Ft. from E. Line

330 Ft. from W. Line

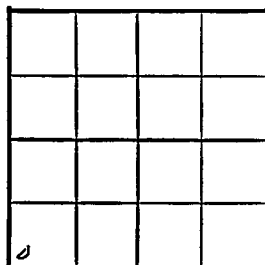

Osborne County

Location

Rig up

Drilling and Remarks:






RECORD

Cased in., ft.

Sand

Gas

Oil


PRODUCTION

1st 24 hrs. Nat.

1st 24 hrs. after shot

Gas Cu. Ft.

Dry Hole

Abandoned

Date

MAR 3 1948 19 S. I. LEWIS Scout