


DX 78-1

Section 5 Township 8 Range 25 W

Well No. 1 Hurlbut

Company Trans-Era

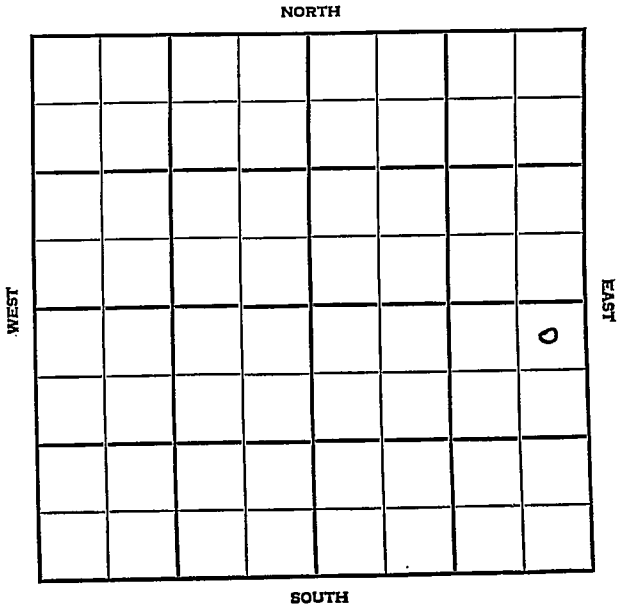

9

Graham

KANSAS

SEC.	TWP.	R.
5	8	25W 1

WELL NO.

1 Hurlbut

FARM

COMPANY

Trans-Era

CONTRACTOR

Trans-Era


Wildcat

330 Ft. from N. Line

Ft. from S. Line

330 Ft. from E. Line

Ft. from W. Line

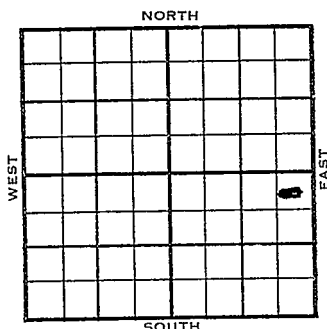

NE NE SE

Sun Oil-DHM

1954	ELEVATION	REPORT
2385'		

6/8

Spudding 6-5-54

8" @ 179

Anhy 2094

Drlg. 2810

6/23

Spud 6-5-54

D&A

TD 4535'

8" @ 179'

Anhy 2094', Heeb 3663', KC 3699',

B KC 3927', Miss 4244', Viola 4314',


Simp. 4502', Arb. 4510'

TD 4535'

D&A

ABANDONED


County Graham State Kansas
 Sec. 5 (Blk.) 8 (Sur.) 25W Map No.
 Operator Trans-Era
 Well No. 1 Farm Hurlbut
 Elev. Location NE NE SE

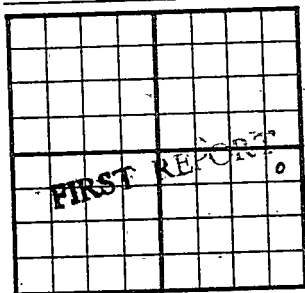

330 Ft. From N Line SE
330 Ft. From E Line Quarter
 1st. Report JUN 9 1954
 Completion
 Remarks Sun Oil - IHM
Trans-Era - Contr.
 Spudding Date 6-5-54

Drig. Data Wildcat

8" @ 179 Anhy 2094 drlg. 2810

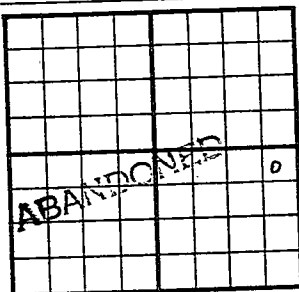County Graham State KansasSec. 5 (Blk. Twp.) 8 (Sur. Rge.) 25W Map No.Operator Trans-EraWell No. 1 Farm HurlbutElev. 2385 Location NE NE SE330 Ft. From N Line SE330 Ft. From E Line Quarter

1st. Report

Completion JUN 23 1954Remarks WildcatTrans-Era - Contr.Spudding Date 6-5-54Drlg. Data D & A TD 45358" @ 179 Anhy 2094 Heeb. 3663KC 3699 B KC 3927 Miss. 4244Viola 4314 Simp. 4502 Arb. 4510TD 4535x D & A

J. G. McGEHEE