

# KANSAS


FORM 51 5M PETROL

Rooks

Section 5 Township 8 Range 20-W

Well No. #8 Strat

Company Continental

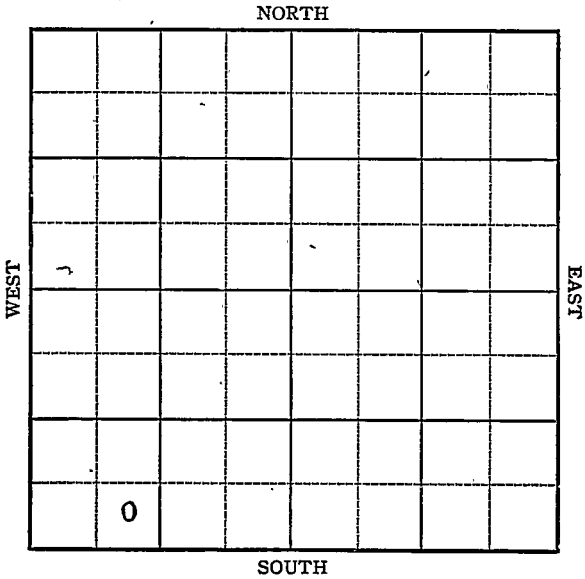

Sec. 5 Twp. 8 R. 20-W

Well No. #8 Strat Farm


Continental Company

\_\_\_\_\_ Ft. from N. Line

330 Ft. from S. Line

\_\_\_\_\_ Ft. from E. Line

990 Ft. from W. Line

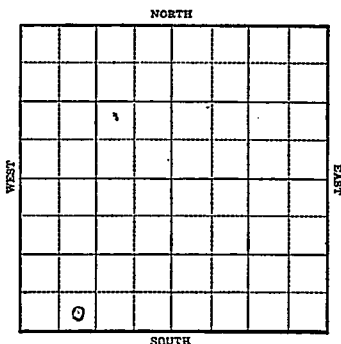

1943

R E P O R T

10/27

Topeka 2936  
Lansing 3178  
SSO 3353-55, 3420-26  
Arkuckle 3462  
T.D. 3486'  
D&A

**FIRST REPORT**  
+  
**ABANDONED**

Map No. 63 Sec. 5 Twp. 8 R. 20W

Well No. 8 Strat. \_\_\_\_\_

\_\_\_\_\_ Continental \_\_\_\_\_ Company

\_\_\_\_\_ FIRST REPORT \_\_\_\_\_ Contractor

SE SW SW <sup>and</sup> ABANDONED

SECTION PLAT


\_\_\_\_\_ Ft. from N. Line

330 Ft. from S. Line

\_\_\_\_\_ Ft. from E. Line

990 Ft. from W. Line

Wildcat

RECORD

Location \_\_\_\_\_

Cased \_\_\_\_\_ in., \_\_\_\_\_ ft.

Rig up \_\_\_\_\_

Sand \_\_\_\_\_

Drilling and Remarks:

Gas \_\_\_\_\_

Topeka 2936

Oil \_\_\_\_\_

Lansing 3178

Total Depth 8486

SSO 3353-55,

3420-26,

Arbuckle 3462

PRODUCTION

D&A

1st 24 hrs. Nat. \_\_\_\_\_

1st 24 hrs. after shot \_\_\_\_\_

Gas \_\_\_\_\_ Cu. Ft.

Dry Hole \_\_\_\_\_

Abandoned \_\_\_\_\_

Date

OCT 27 1943 19

S. J. LEWIS Scout