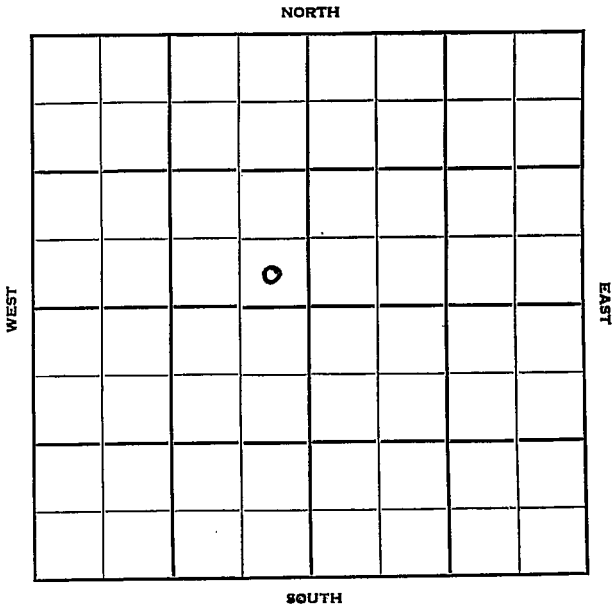


Section 5 Township 8 Range 21 WWell No. # 1 GosselinCompany Davis Bros.

Graham

KANSAS

Sec. 5 Twp. 8 R. 21W

Well No. #1 Gosselin Farm

Davis Bros. Company

Prime Contractor

Wildcat


Ft. from N. Line

330 Ft. from S. Line

330 Ft. from E. Line

Ft. from W. Line

SE SE NW

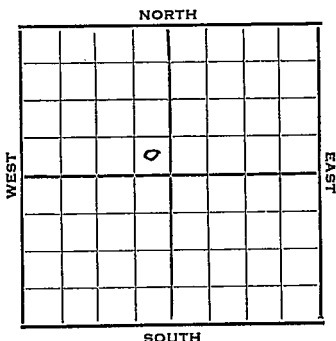

1952

Elv. 2064'

REPORT

5/28

Moving In.

6/11

Spud 5-28-52

D & A TD 3648' 8" @ 185

Anhy 1650' Heeb 3248' KC 3284'

DST 3307-28 open 1 hr. rec 15' mud

DST 3355-80 open 1 hr. rec 200' mud

DST 3432-82 open 1 hr. rec 42' mud

Cong. 3577' Arb. 3623'

TD 3648' D & A

ABANDONED

County Graham State KansasSec. 5 (Blk. 8 (Sur. 21W Map No.Operator Davis Bros.Well No. 1 Farm GosselinElev. Location SE SE NW330 Ft. From S Line NW330 Ft. From E Line Quarter1st. Report MAY 28 1952

Completion

Remarks


Prime - Contr.

Spudding Date

Drilg. Data

WildcatMI

J. G. McGEHEE

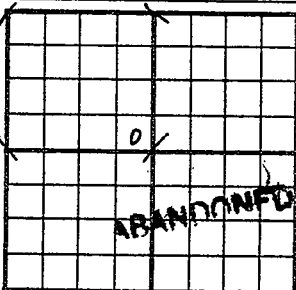County Graham State KansasSec. 5 (Blk. 8) (Sur. 21W) Map No. Operator Davis Bros.Well No. 1 Farm GosselinElev. 2064 Location SE SE NW330 Ft. From S Line NW330 Ft. From E Line Quarter1st. Report Completion JUN 11 1952Remarks WildcatPrime Drlg. - Contr.Spudding Date 5-28-52Drlg. Data D & A TD 36488" @ 185 Arhy 1650 Heeb. 3248KC 3284 DST 3307-28 open 1 hr.Rec. 15' mud DST 3355-80 open 1 hr.Rec. 200' mud DST 3432-82 open 1 hr.Rec. 42' mud Cong. 3577 Arb. 3623TD 3648 D & A

J. G. McGEHEE.