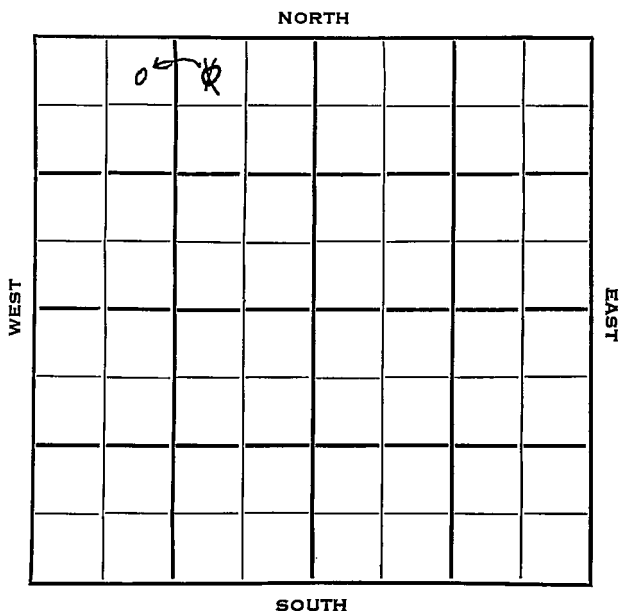


Section 5 Township 8 Range 22WWell No. 3 SanfordCompany Anderson-Prichard

Graham

KANSAS

SEC.	TWP.	R.
5	8	22W

WELL NO.

#3 Sanford

FARM

COMPANY

Anderson-Prichard

CONTRACTOR


330

Ft. from N. Line

Ft. from S. Line

Ft. from E. Line

Ft. from W. Line

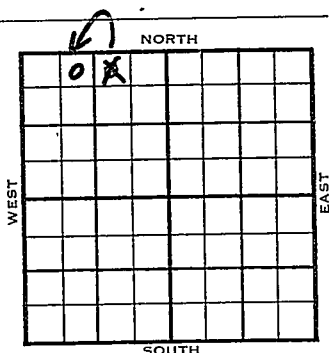

~~NW NE NW~~
NE NW NW

1953

ELEVATION

2170'

REPORT

10/28

Cellar & Pits.

11/4

8" @ 209 w/150

Anhy 1780'

Drlg. 2460'

11/11

Top 3154 Heeb 3367 Tor 3389

Lans 3407' RTD 3812 Schl 5" set

11/18

5" @ 3654 CO 3597 16/3572-76

S/12 Bo & 1 BW 6 hrs.

12/2

Spud 10-31-53

Oil Well

TD 3812'

8" @ 209'

Anhy 1780', Top 3154', Heeb 3367',

Tor 3389', Lans 3407'

TD 3812'

5" @ 3654'

CO to 3597', 16/3572-76

S/12 bo 1 bw 6 hrs., S/1 boph 2 hrs.

250A

S/12 bo 1 bw 6 hrs.

Comp. 28 bopd 3 bw

COMPLETED

County Graham State Kansas
 Sec. 5 (Blk.) 8 (Sur.) 22W Map No.
 Operator Anderson-Prichard
 Well No. 3 Farm Sanford
 Elev. _____ Location NW NE NW

		0							

330 Ft. From N Line NW
990 Ft. From E Line Quarter
 1st. Report OCT 28 1953

Completion _____

Remarks _____

Spudding Date _____

Drilg. Data _____

Cellar & pits

Kansas

Map No. _____ Sec. 5 Twp. 8 R. 22WWell No. 3 SanfordAnderson-Prichard Company**CORRECTION**

Contractor

NE NW NW

SECTION PLAT

330 Ft. from N. Line

_____ Ft. from S. Line

_____ Ft. from E. Line

990 Ft. from W. Line

0			

Graham County

Location _____

Rig up _____

Drilling and Remarks:

Reported
NW NE NW

RECORD

Cased _____ in., _____ ft.

Sand _____

Gas _____

Oil _____

Total Depth _____

PRODUCTION

1st 24 hrs. Nat. _____

1st 24 hrs. after shot _____

Gas _____ Cu. Ft.

Dry Hole _____

Abandoned _____

Date

NOV 4 1953

J. G. McGEHEE Scout

County Graham State Kansas
 Sec. 5 (Blk. 8 (Sur. 22W (Rge. Map No.
 Operator Anderson-Prichard
 Well No. 3 Farm Sanford
 Elev. 2170 Location NE NW NW

0									

330 Ft. From N Line NW

990 Ft. From W Line Quarter

1st. Report

Completion DEC 2 1953

Remarks

Spudding Date 10-31-53

Drilg. Data Oil well TD 3812

8" @ 209 Anhy 1780 Top. 3154

Heeb. 3367 Tor. 3389 Lans. 3407

TD 3812 5" @ 3654 CO to 3597

16/ 3572-76 S/ 12 bo 1 bw 6 hr.

S/ 1 boph 2 hr. 250 A S/ 12 bo

1 bw 6 hr. Comp. 28 bopd 3 bw

J. G. McGEHEE