


*Rooks*

KANSAS

Section 6 Township 8 Range 19W

Well No. #1 McCormick

Company Carl Todd

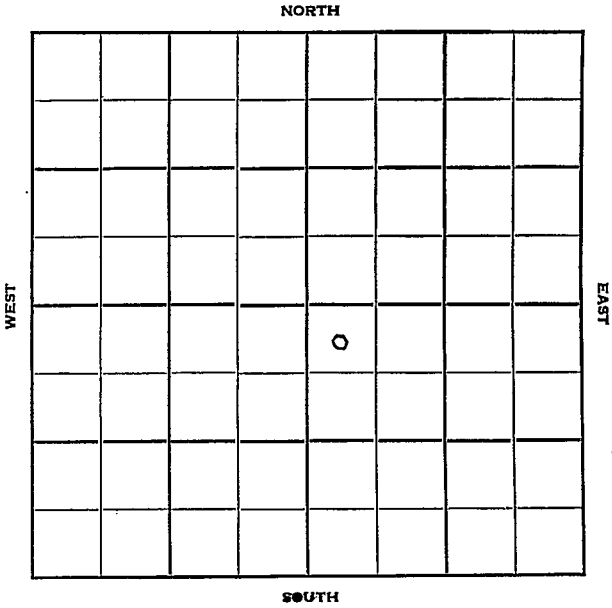


Sec. 6 Twp. 8 R. 19W

Well No. #1 McCormick Farm

Carl Todd Company

Contractor

\_\_\_\_\_ Ft. from N. Line  
2310 Ft. from S. Line  
2310 Ft. from E. Line  
 \_\_\_\_\_ Ft. from W. Line  
 NW NW SE

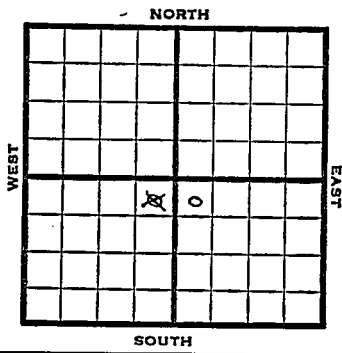

1951

Elev. 1883' REPORT

11/21

Spud 11-10-51  
 8" @ 1120  
 Anhy 1345 Heeb. 3064 Lans. 3102  
 DST 3143-90 open 1/2 hr.  
 Rec. 180' mud & SW  
 Drlg. 3191'

11/28

Spud 11-10-51  
 D&A TD 3420  
 8" @ 1120  
 Anhy 1345 Heeb. 3064  
 Lans. 3102  
 DST 3143-90 open 1/2 hr.  
 Rec. 180' mud & SW  
 Arb. 3358-3420 TD  
 D&A

**ABANDONED**

County Rooks State KansasSec. 6 (Blk. Twp.) 8 (Sur. Rge.) 19W Map No.Operator Carl ToddWell No. 1 Farm McCormickElev. Location NW NW SE


2310 Ft. From S Line SE2310 Ft. From E Line Quarter1st. Report NOV 21 1951

Completion \_\_\_\_\_

Remarks \_\_\_\_\_

Spudding Date 11-10-51

Drlg. Data

8" @ 1120 Anyh 1345 Heeb. 3064Lans. 3102 DST 3143-90 open  $\frac{1}{2}$  hr.Rec. 180<sup>+</sup> mud & SW drlg. 3191

J. E. TYRA

