FORM 51 25M 3-49 PETROL


KANSAS

Rooks

Section 6 Township 8 Range 17W

Well No. #1 Goldie

Company Murfin Drlg. Company

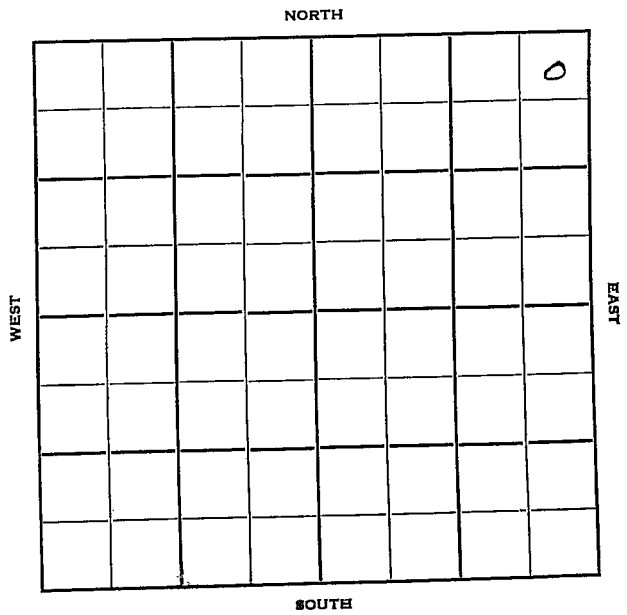

FORM 252-B

Rooks

KANSAS ✓

Sec. 6 Twp. 8 R. 17 W

Well No. # 1 Goldie Farm

Murfin Drlg. Company

Murfin Drlg. Contractor

Semi-Wildcat

330 Ft. from N. Line


Ft. from S. Line

330 Ft. from E. Line

Ft. from W. Line

NE NE NE

Lion - DHM

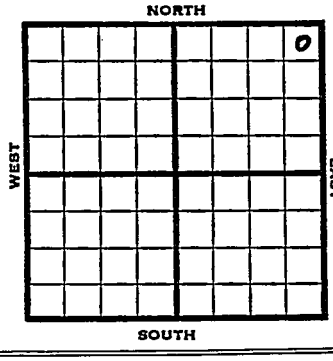

1953	Elev. 1862 REPORT
3/18	Spud 3-14-53 8" @ 128 Anhy 1234' Drlg. 1970'
3/26	Top 2772, Heeb 2986, Tor 3009, KC 3038, DST 3076-3101, 20' M, 990# DST 3120-35, 1 hr., 795' SW, 1125# FP 400# DST 3023-77, 1 hr., 20' M + SSO Drlg. 3153'
4/2	Spud 3-14-53 D & A TD 3345 8" @ 128 Anhy 1234, Top 2772, Heeb 2986, Tor 3009, KC 3028 DST 3076-3101 Rec. 20' mud DST 3120-35 open 1 hr. Rec 795' SW 1125# DST 3023-77 open 1 hr. Rec 20' mud & SSO ReArb 3324. Arb 3331 TD 3345 D & A **ABANDONED**

FORM 275 FOR SALE BY KANSAS BLUE PRINT CO.


County Rooks State Kansas

Sec. 6 (Blk. Twp.) 8 (Sur. Rge.) 17W Map No.

Operator Murfin Drlg.

Well No. 1 Farm Goldie

Elev. Location NE NE NE

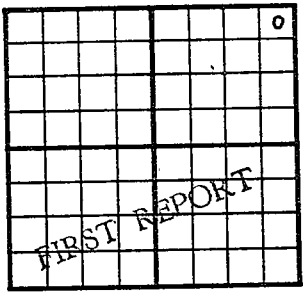

330 Ft. From N Line NE

330 Ft. From E Line Quarter

1st. Report MAR 1 8 1953

Completion

Remarks Lion - DHM

Murfin Drlg. - Contr.

Spudding Date 3-14-53

Drlg. Data Semi Wildcat

8" @ 128 Anhy 1234 drlg. 1970

J. G. McGEHEE

FORM 275 FOR SALE BY KANSAS BLUE PRINT CO.


County Rooks State Kansas

Sec. 6 (Blk. Twp.) 8 (Sur. Rge.) 17W Map No.

Operator Murfin Drlg.

Well No. 1 Farm Goldie

Elev. 1862 Location NE NE NE

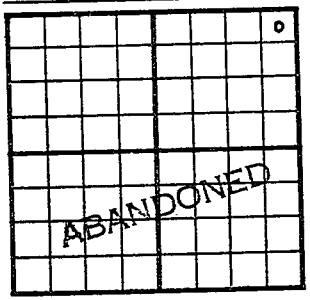

330 Ft. From N Line NE

330 Ft. From E Line Quarter

1st. Report

Completion APR 1 1953

Remarks Semi Wildcat

Murfin Drlg. - Contr.

Spudding Date 3-14-53

Drlg. Data D & A TD 3345

8" @ 128 Anhy 1234 Top. 2772

Heeb. 2986 Tor. 3009 KC 3028

DST 3076-3101 Rec. 20' mud DST 3120-35

open 1 hr. Rec. 795' sw 1125#

DST 3023-77 open 1 hr. Rec. 20' mud &

SSO ReArb. 3324 Arb. 3331 TD 3345

D & A

J. G. McGEHEE