FORM 51 IOM 12-46 PETROL


KANSAS

Rooks

Section 6 Township 8 Range 17W

Well No. 1 Stamper

Company Stanolind

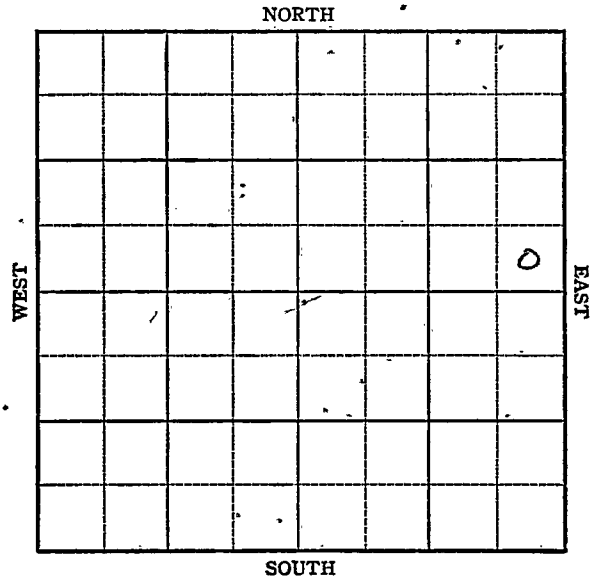

FORM 252-A
5M 12-46 PETROL

KANSAS


Rooks

Sec. 6 Twp. 8 R. 17-W

Well No. #1 Stamper Farm

Stanolind Company

Wildcat

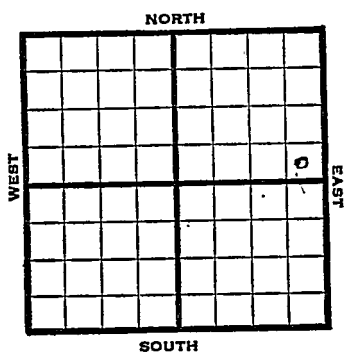

_____ Ft. from N. Line

330 Ft. from S. Line

330 Ft. from E. Line

_____ Ft. from W. Line

SE NE

1947	REPORT Elev. 1849'
5/21	Location
5/27	13" @ 158' Anhydrite 1260' Drlg. 1305'
6/3	Topeka 2760 Drlg 2910'
6/10	Lansing 3005 Drlg. 3228'
6/21	Arbuckle (3209' 3309?) 5" @ 3310' TD 3325 Rust
6/24	500 Acid
7/1	Drlg 3328 500 acid ½bbl oil PH 8 hrs. Drlg 3357
7/8	TD 3385 HFW PB 3284 WOC

OVER

7-16 PB 3161
12- shots
P 112-14
2 bbls W
PH

7/23 Arbuckle (3209' 3309?)
5" @ 3310' T.D. 3325'
Abandoned

ABANDONED

Form 26 200 Bks. 10-46 Petrol Kansas KANSAS Wildcat

Map No. 1764 Sec. 6 Twp. 8 R. 17W


Well No. 1 Stamper

Stanolind Company

FIRST REPORT Contractor

SE NE

SECTION PLAT

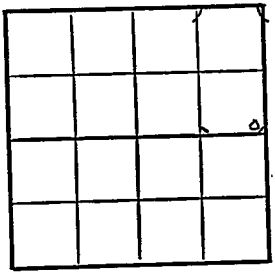

____ Ft. from N. Line

330 Ft. from S. Line

330 Ft. from E. Line

____ Ft. from W. Line

Rooks County

Location x

Rig up

Drilling and Remarks:

RECORD

Cased ____ in., ____ ft.

Sand

Gas

Oil

Total Depth

PRODUCTION

1st 24 hrs. Nat.

1st 24 hrs. after shot

Gas ____ Cu. Ft.

Dry Hole

Abandoned

Date

MAY 21 1947 19 S. J. LEWIS Scout

Wildcat

Form 26 200 Bks. 10-46 Petrol.
Kansas

Map No. 64 Sec. 6 Twp. 8 R. 17W

Well No. 1 Stamper


Stanolind Company

ABANDONED Contractor

E. 1849

SE NE

SECTION PLAT

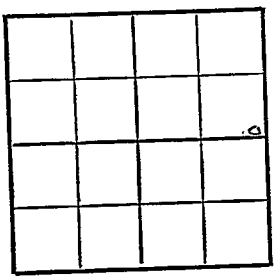

Ft. from N. Line

330 Ft. from S. Line

330 Ft. from E. Line

Ft. from W. Line

Rooks County

Location

Rig up

Drilling and Remarks:

Cir 3209
5-3318

RECORD

Cased in., ft.

Sand

Gas

Oil

Total Depth 3325-

PRODUCTION

1st 24 hrs. Nat.

1st 24 hrs. after shot

Gas Cu. Ft.

Dry Hole

Abandoned

Date

JUL 23 1947 19

S. J. LEWIS Scout